

Section 14 Township 9 Range 21-WWell No. #1 BraultCompany Harbar Drlg.

NORTH

WEST

EAST

						0	

SOUTH

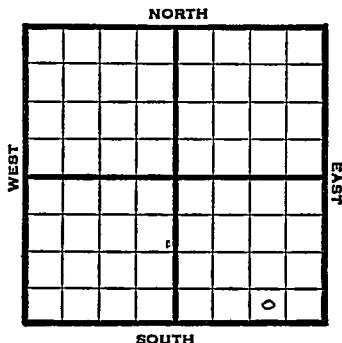
16

KANSAS

Graham

Sec. 14 Twp. 9 R. 21WWell No. #1 Brault FarmHarber Drlg. Company

Morel Pool

 Ft. from N. Line330' Ft. from S. Line990' Ft. from E. Line Ft. from W. Line

SW SE SE

SOUTH

1948 Eli 2258' REPORT

6/23 Surface Hole

6/29 Lansing 3453'

Drlg. 3725'

10" @ 90'

6/8 Arb. 3763'

TD 3766'

5" @ 3763' - 2900' Oil

7/14

"

7/21

7/28 Arb. 3763'

5" @ 3763'

TD 3766'

Pump 25 oil Pot.

27° Gr.

Comp

COMPLETED

Map No. _____ Sec. 14 Twp. 9 R. 21W

Well No. 1 Brault

Harbar Drlg.

Company

FIRST REPORT

Contractor

SW SE SE

SECTION PLAT

_____ Ft. from N. Line

330 Ft. from S. Line

990 Ft. from E. Line

_____ Ft. from W. Line

Graham County

RECORD

Location _____

Cased _____ in., _____ ft.

Rig up _____

Sand _____

Drilling and Remarks:

Gas _____

surface hole

Oil _____

Total Depth _____

PRODUCTION

1st 24 hrs. Nat. _____

1st 24 hrs. after shot _____

Gas _____ Cu. Ft.

Dry Hole _____

Abandoned _____

Date

JUN 23 1948 19

S. J. LEWIS

Scout

