

KANSAS


FORM 51 5M PETROL

Graham

Section 14 Township 9 Range 21W

Well No. #1 Armand Brault

Company Sinclair-Prairie

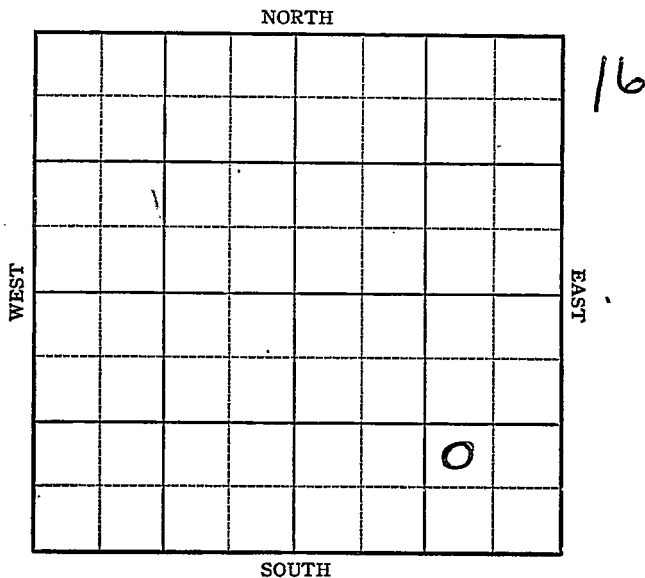

**KANSAS**

Graham

Sec. 14 Twp. 9 R. 21W

Well No. #1 Armand Brault Farm

Sinclair-Prairie Company


Morel Pool

\_\_\_\_\_ Ft. from N. Line

990 Ft. from S. Line

990 Ft. from E. Line

\_\_\_\_\_ Ft. from W. Line

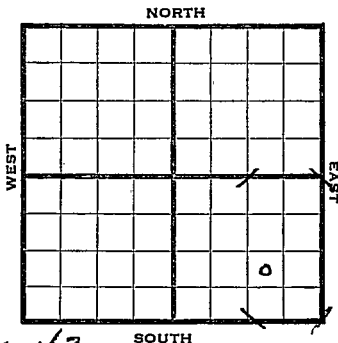

*Elev. 2243*

1944

REPORT

4/19	Location
4/26	"
5/3	"
5/10	"
5/17	"
5/24	"
8/2	"
5/31	"
6/7	"
6/15	RUR
6/21	10" @ 250 Drlg. 1220'
6/28	Drlg 2870
7/12	Lans 3433 Arb 3769-75 TD Run csg
7/19	Simp 3741 Arb 3758 Core TD 3772 5" @ 3772 RUST
7/26	18 showsto 3757-62 1000 acid sub. 80 oil in 4 hrs.
8/2	" " " " " " " "
8/9	" " " " " " " "
8/16	" " " " " " " "
8/233	" " " " " " " "
8/3	" " " " " " " "

**OVER**

1944

9/6

Arb 3758  
5" @ 3772  
Perf. Arb.  
1000' acid.  
TD 3772'  
Depth Pot 6400  
Max 3000  
29.3 gravity

COMPLETED

**KANSAS**

Pool Name Morel Pool

Map No. 65 Sec. 14 Twp. 9 R. 21W

Well No. 1 Armand Brault

Sinclair-Prairie Company

**FIRST REPORT** Contractor

NW SE SE

**SECTION PLAT**

			0

\_\_\_\_\_ Ft. from N. Line

990 Ft. from S. Line

990 Ft. from E. Line

\_\_\_\_\_ Ft. from W. Line

Graham County

Location X

Rig up \_\_\_\_\_

Drilling and Remarks:

**RECORD**

Cased \_\_\_\_\_ in., \_\_\_\_\_ ft.

Sand \_\_\_\_\_

Gas \_\_\_\_\_

Oil \_\_\_\_\_

Total Depth \_\_\_\_\_

**PRODUCTION**

1st 24 hrs. Nat. \_\_\_\_\_

1st 24 hrs. after shot \_\_\_\_\_

Gas \_\_\_\_\_ Cu. Ft.

Dry Hole \_\_\_\_\_

Abandoned \_\_\_\_\_

Date

APR 1 9 1944 19

S. J. LEWIS Scout

Pool Name Mörel Pool

Map No. KANSAS Sec. 14 Twp. 9 R. 21W

Well No. 1 Armand Brault

Sinclair-Prairie Company

**COMPLETED** Contractor

NW SE SE

SECTION PLAT

\_\_\_\_\_ Ft. from N. Line

990 Ft. from S. Line

990 Ft. from E. Line

\_\_\_\_\_ Ft. from W. Line

			o

Graham County

Location \_\_\_\_\_

Rig up \_\_\_\_\_

Drilling and Remarks:

*CE 83758.  
5' @ 3772.  
Perf. 2 ft.  
1000 cu. ft.  
Depth. Po 6400  
Map 3000*

RECORD

Cased \_\_\_\_\_ in., \_\_\_\_\_ ft.

Sand \_\_\_\_\_

Gas \_\_\_\_\_

Oil \_\_\_\_\_

Total Depth 3222

PRODUCTION

1st 24 hrs. Nat. \_\_\_\_\_

1st 24 hrs. after shot \_\_\_\_\_

Gas \_\_\_\_\_ Cu. Ft.

Dry Hole \_\_\_\_\_

Abandoned \_\_\_\_\_

Date

*293 Gr*

SEP 6 1944 19

S. J. LEWIS

Scout