

KANSAS  
KANSAS


FORM 51 5M BR1X

Graham County

Section 14 Township 9 Range 21W

Well No. #1 Hinkhouse "A"

Company Bridgeport

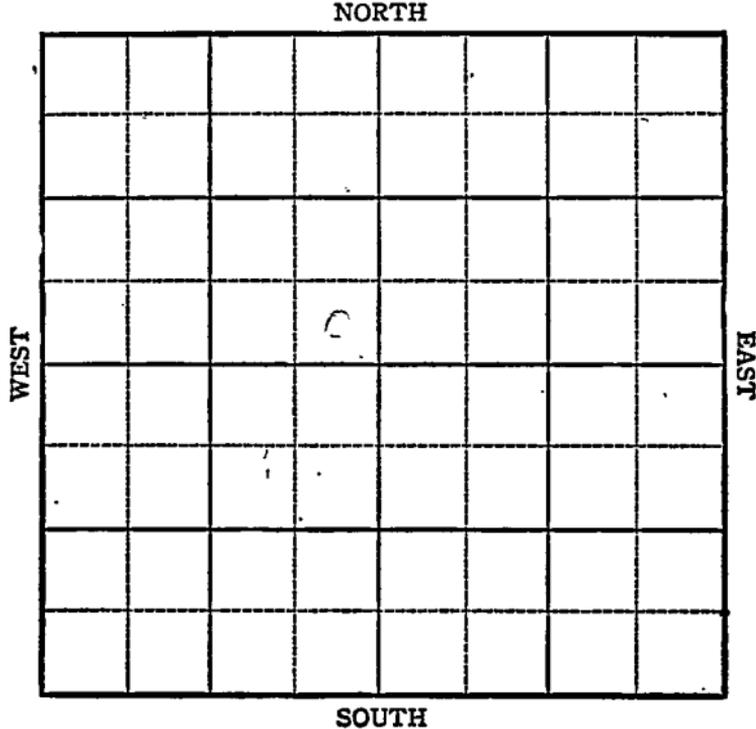

KANSAS

Sec. 14 Twp. 9 R. 21W

Well No. 1 Hinkhouse "A" Farm

Bridgeport Company


Morel

\_\_\_\_\_ Ft. from N. Line

330 Ft. from S. Line

330 Ft. from E. Line

\_\_\_\_\_ Ft. from W. Line

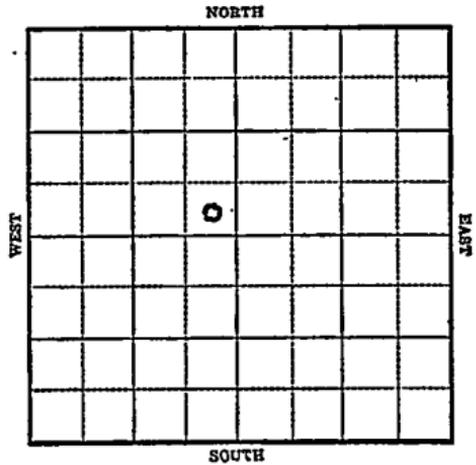

SE NW Elev. 2226

1944

R E P O R T

7/5

Rotary

7/12

8" @ 212 Drlg 2321

Heefner 3360

B Oread 3395

Lans 3400

Drlg 3453

7/26

B KC 3260

Cong. 3667

Simp 3680

Arb. 3702-03

TD

Sat. 5" @ 3702 RUST

8/9

Arb. 3702

5" @ 3702

Depth Pot. 31560

Max 3000

Grav. 24.8

TD 3709

COMPLETED

KANSAS


Pool Name MorelMap No. 65 Sec. 14 Twp. 9 R. 21WWell No. 1 Hinkhouse "A"Bridgeport Company

## FIRST REPORT

Contractor

SE NW

## SECTION PLAT

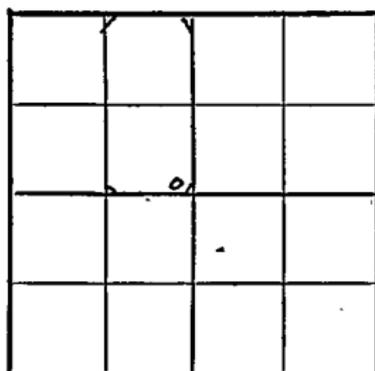

\_\_\_\_\_ Ft. from N. Line

330 Ft. from S. Line330 Ft. from E. Line

\_\_\_\_\_ Ft. from W. Line

Graham County

Location \_\_\_\_\_

Rig up \_\_\_\_\_

Drilling and Remarks:

Rotary

## RECORD

Cased \_\_\_\_\_ in., \_\_\_\_\_ ft.

Sand \_\_\_\_\_

Gas \_\_\_\_\_

Oil \_\_\_\_\_

Total Depth \_\_\_\_\_

## PRODUCTION

1st 24 hrs. Nat. \_\_\_\_\_

1st 24 hrs. after shot \_\_\_\_\_

Gas \_\_\_\_\_ Cu. Ft.

Dry Hole \_\_\_\_\_

Abandoned \_\_\_\_\_

Date

JUL 5 1944 19

S. J. LEWIS Scout

Pool Name Mor el

Map No. KANSAS 12.5 Sec. 14 Twp. 9 R. 21W

Well No. 1 Hinkhouse "A"

Bridgeport Company

**COMPLETED** Contractor

SE NW

SECTION PLAT


\_\_\_\_\_ Ft. from N. Line

330 Ft. from S. Line

330 Ft. from E. Line

\_\_\_\_\_ Ft. from W. Line

Graham County

Location \_\_\_\_\_

Rig up \_\_\_\_\_

Drilling and Remarks:

*Per 83702*  
*5" C3702*  
*Depth Per 831560*  
*May 13000*  
*24 5/8*

RECORD

Cased \_\_\_\_\_ in., \_\_\_\_\_ ft.

Sand \_\_\_\_\_

Gas \_\_\_\_\_

Oil \_\_\_\_\_

Total Depth 3709

PRODUCTION

1st 24 hrs. Nat. \_\_\_\_\_

1st 24 hrs. after shot \_\_\_\_\_

Gas \_\_\_\_\_ Cu. Ft.

Dry Hole \_\_\_\_\_

Abandoned \_\_\_\_\_

Date

AUG 9 1944 19

S. J. LEWIS Scout