


Graham

KANSAS

Section 14 Township 9 Range 21W

Well No. #2 Hinkhouse "A"

Company Bridgeport

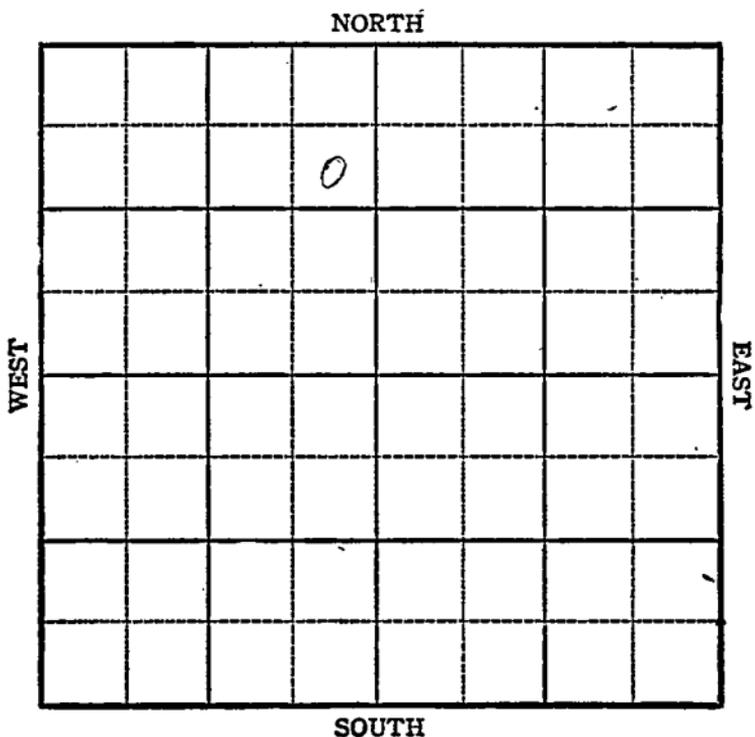

KANSAS

Graham County

Sec. 14 Twp. 9 R. 21W

Well No. #2 Hinkhouse "A" Farm

Bridgeport Company

Morel


NORTH

990 Ft. from N. Line

_____ Ft. from S. Line

330 Ft. from E. Line

_____ Ft. from W. Line

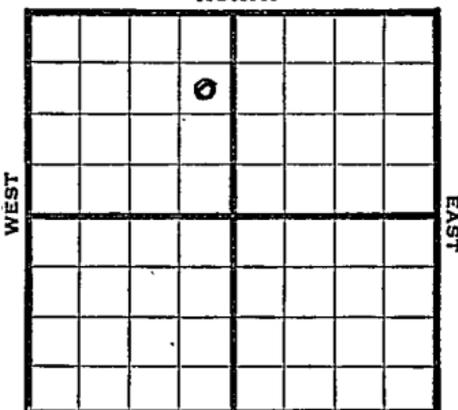

SE NE ~~SW~~ Elev. 2221

SOUTH

1944

REPORT


8/9 Rot.
8/16 8" @ 215
Drlg. 2808
8/23 Lans 3399
Simp 3673
Arb 3691-95 TD-Sat.
5" @ 3691 RUST
8/30 " " " " " "
9/8 TD 3701 swb 31 oil per hr 12 hrs.
500 acid
9-13 Arb 3691
5" @ 3691
500 acid
Depth Pot 4591
Max 3000
29.3 Gr.
TD 3701

COMPLETED

Pool Name MorelMap No. 1635A2 Sec. 14 Twp. 9 R. 21WWell No. 2 Hinkhouse "A"Bridgeport Company**FIRST REPORT** Contractor

SE NE NW

SECTION PLAT

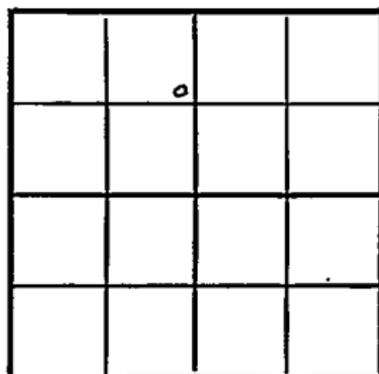990 Ft. from N. Line Ft. from S. Line330 Ft. from E. Line Ft. from W. LineGraham CountyLocation Rig up

Drilling and Remarks:

Rotary

RECORD

Cased in., ft.Sand Gas Oil Total Depth

PRODUCTION

1st 24 hrs. Nat. 1st 24 hrs. after shot Gas Cu. Ft.Dry Hole Abandoned

Date

AUG 9 1944 19S. J. LEWIS Scout

Pool Name Moral PoolMap No. 65 Sec. 14 Twp. 9 R. 21 WWell No. 2 Hinkhouse "A"Bridgeport Company**COMPLETED**

Contractor

SE NE NW

SECTION PLAT

990 Ft. from N. Line Ft. from S. Line330 Ft. from E. Line Ft. from W. Line

	0		

Graham County

Location Rig up

Drilling and Remarks:

See 436915" @ 3691500 acidDept 160 P & S. 4591Max 3000293 ft

RECORD

Cased in., ft.Sand Gas Oil Total Depth 3701

PRODUCTION

1st 24 hrs. Nat. 1st 24 hrs. after shot Gas Cu. Ft.Dry Hole Abandoned

Date

SEP 13 1944

19

S. J. LEWIS

Scout