

KANSAS

Graham

FORM 51 5M 10-41 PETROL

Section 14 Township 9 Range 21-W

Well No. #3 A. Morel

Company Continental Etal.

NORTH

0							

SOUTH

WEST

EAST

S

KANSAS

Graham

Sec. 14 Twp. 9 R. 21-W

Well No. #3 A. Morel Farm

Continental etal Company


Morel

_____ Ft. from N. Line

_____ Ft. from S. Line

_____ Ft. from E. Line

_____ Ft. from W. Line

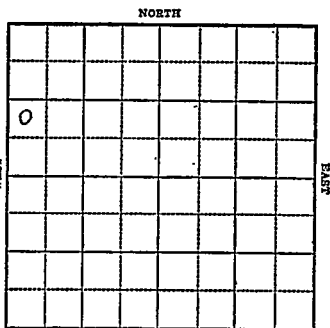

NW SW NW El. 2272

1943

R E P O R T

2/17 Derrick
2/24 10" Casing 242
Selg. 2000'
3/3 Lans 3470
Cong. 3645
Drlg. 3772'
3/10 Arb. 3875
T.D. 3889'
No shows.

ABANDONED

Graham

KANSAS

Map No. 65 Sec. 14 Twp. 9 R. 21WWell No. 3 A. MorelContinental et al. CompanyFIRST REPORT Contractor

NW SW NW

 Ft. from N. Line990 Ft. from S. Line Ft. from E. Line330 Ft. from W. Line

SECTION PLAT

o			

MOREL POOL

Location Rig up

Drilling and Remarks:

Derrick

RECORD

Cased in., ft.Sand Gas Oil Total Depth

PRODUCTION

1st 24 hrs. Nat. 1st 24 hrs. after shot Gas Cu. Ft.Dry Hole Abandoned

Date

FEB 17 1943

19

S. J. LEWIS

Scout

Graham

KANSAS

Map No. 5 Sec. 14 Twp. 9 R. 21WWell No. 3 A. Morel

Continental etal.

Company

ABANDONED

Contractor

NW SW NW

SECTION PLAT

0			

Ft. from N. Line

990

Ft. from S. Line

Ft. from E. Line

330

Ft. from W. Line

MOREL POOL

Location

Rig up

Drilling and Remarks:

C₂ 83875

Nos 40002

RECORD

Cased _____ in., _____ ft.

Sand _____

Gas _____

Oil _____

Total Depth 3889

PRODUCTION

1st 24 hrs. Nat. _____

1st 24 hrs. after shot _____

Gas _____ Cu. Ft.

Dry Hole _____

Abandoned _____

Date

MAR 10 1943

19

S. I. LEWIS

Scout