


KANSAS

Section 14 Township 9 Range 21W

Well No. 3 Knipp

Company Shell

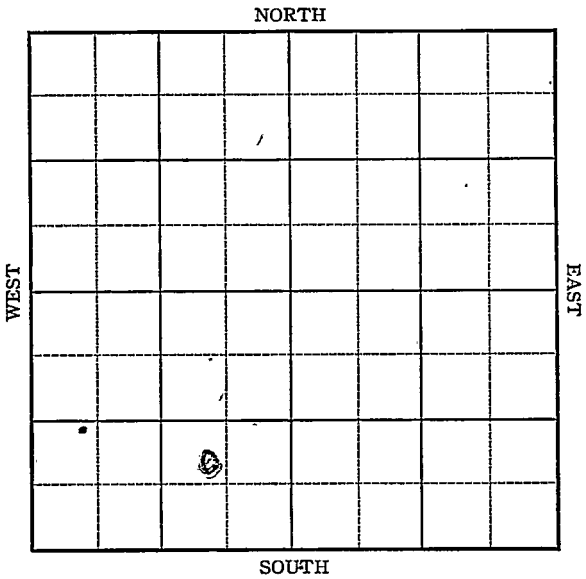

KANSAS

Graham

Sec. 14 Twp. 9 R. 21W

Well No. #3 Knipp Farm

Shell Company

Mörel


NORTH

 Ft. from N. Line

988' Ft. from S. Line

963' Ft. from E. Line

 Ft. from W. Line

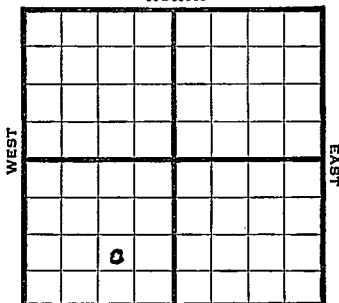

Elev. 2243

1944

REPORT

6/28

Drilling 1454' "

7/12

Cong. 3695 Drlg 3717

7/19

Topeka 3196 Lans 3418
Simp. 3721 Arb 3737-40 TD
4" @ 3739 RUST

7/26

TD 3743 sat. 133 oil in 3 hrs.

8/2

Arb 3737
4" @ 3739
Echo Pot 4802
Max 3000
TD 3743
Grav. 29.3

COMPLETED

KANSAS

Pool Name MorelMap No. 65 Sec. 14 Twp. 9 R. 21WWell No. 3 KnippShell

Company

FIRST REPORT

Contractor

NW SE SW

SECTION PLAT

	o		

_____ Ft. from N. Line

988

_____ Ft. from S. Line

963

_____ Ft. from E. Line

_____ Ft. from W. Line

Graham County

Location _____

Rig up _____

Drilling and Remarks:

1454'

RECORD

Cased _____ in., _____ ft.

Sand _____

Gas _____

Oil _____

Total Depth _____

PRODUCTION

1st 24 hrs. Nat. _____

1st 24 hrs. after shot _____

Gas _____ Cu. Ft.

Dry Hole _____

Abandoned _____

Date

JUN 28 1944 19S. J. LEWIS

Scout

KANSAS

Pool Name MorelMap No. 65 Sec. 14 Twp. 9 R. 21WWell No. 3 Knipp

Shell

Company

COMPLETED

Contractor

NW SE SW

SECTION FLAT

	o		

_____ Ft. from N. Line

988 Ft. from S. Line963 Ft. from E. Line

_____ Ft. from W. Line

Graham County

Location _____

Rig up _____

Drilling and Remarks:

Core 37374" @ 3739Echo Pt 4802Blk 3000293/4

RECORD

Cased _____ in., _____ ft.

Sand _____

Gas _____

Oil _____

Total Depth 3743

PRODUCTION

1st 24 hrs. Nat. _____

1st 24 hrs. after shot _____

Gas _____ Cu. Ft.

Dry Hole _____

Abandoned _____

Date

AUG 2 1944 19

S. J. LEWIS

Scout