


Section 14 Township 9 **KANSAS** Range 21W
Well No. 5 Knipp
Company Shell

Morel Pool
NORTH

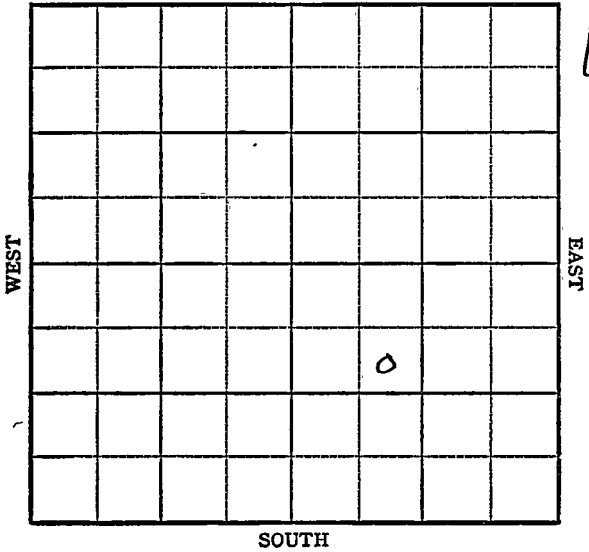

KANSAS

Graham

Sec. 14 Twp. 9 R. 21W

Well No. #5 Knipp Farm

Shell

Company

Morel Pool


990' Ft. from N. Line

 Ft. from S. Line

 Ft. from E. Line

990' Ft. from W. Line

SE NW SE

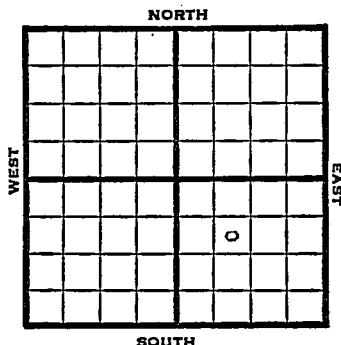

1948

Eli 2263'

REPORT

10/20

RUR

10/26

8" @ 1728'

Drlg 2551'

11/3

Topeka 3208'

Lansing 3445'

Drlg. 3580'

11/10

Arbuckle 3741'

4" @ 3821'

TD 3823'

39 shots 3740-50

900' oil 3 hr SW

11/16

500 acid swb 190 bbls oil 3 hrs.

11/23

TD 3823'

Arb. 3741'

4" @ 3821'

Perf 500 acid

Depth Pot 3000 Oil

30° Gr.

Comp

COMPLETED

Map No. _____ Sec. 14 Twp. 9 R. 21WWell No. 5 Knipp

Shell

Company

FIRST REPORT

Contractor


SE NW SE

SECTION PLAT

990 Ft. from N. Line

_____ Ft. from S. Line

_____ Ft. from E. Line

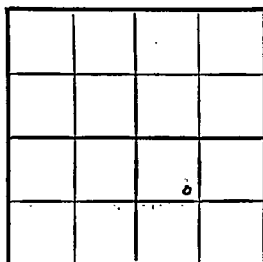990 Ft. from W. Line

Graham County

RECORD

Location _____

Cased _____ in., _____ ft.

Rig up _____

Sand _____

Drilling and Remarks:

Gas _____

Oil _____

Total Depth _____

R U R

PRODUCTION

1st 24 hrs. Nat. _____

1st 24 hrs. after shot _____

Gas _____ Cu. Ft.

Dry Hole _____

Abandoned _____

Date

OCT 20 1948 19S. J. LEWIS

Scout

Kansas

Morel Pool

Map No. 65 Sec. 14 Twp. 9 R. 21WWell No. #5 E Knipp

Shell

Company

COMPLETE

Contractor

SE NW SE


E/ 2263

SECTION PLAT

990 Ft. from N. Line

Ft. from S. Line

Ft. from E. Line

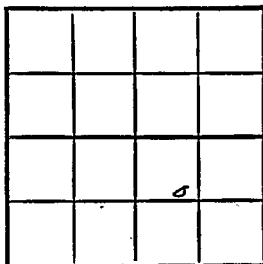990 Ft. from W. Line

Graham County

Location

Rig up

Drilling and Remarks:

Art 37414" @ 3821Prof.5000 cuDepth 8000 cu300 cu

RECORD

Cased _____ in., _____ ft.

Sand _____

Gas _____

Oil ☒Total Depth 3823

PRODUCTION

1st 24 hrs. Nat. 1.51st 24 hrs. after shot 1.5

Gas _____ Cu. Ft.

Dry Hole _____

Abandoned 1

Date

NOV 23 1948

S. J. LEWIS

Scout