

Graham


KANSAS

FORM 51 IOM 12-46 PETROL

Section 14 Township 9 Range 21W

Well No. 7 Morel "A"

Company Continental

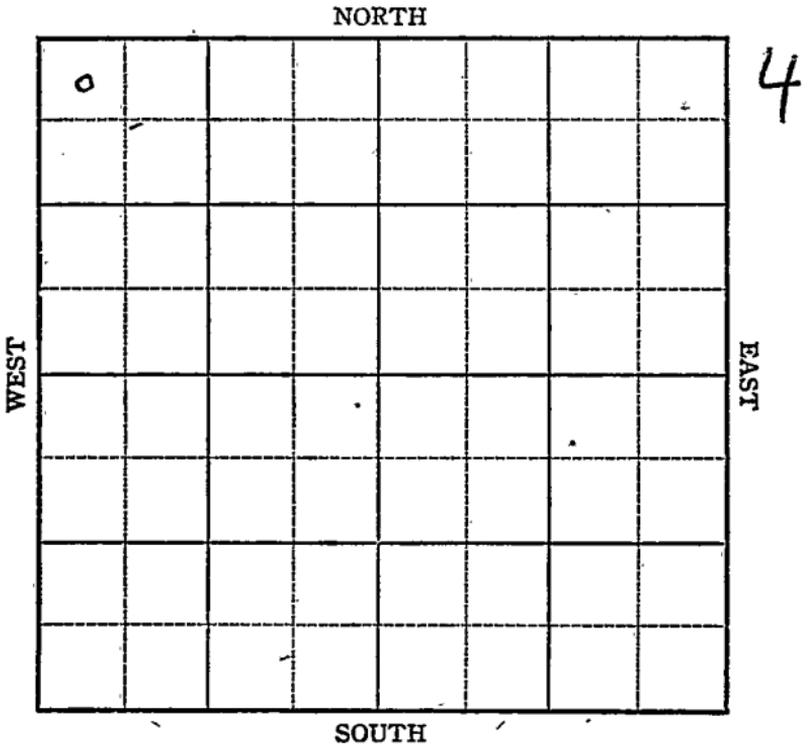

14

KANSAS 9

Graham
Morel

21W

Sec. _____ Twp. _____ R. _____

Well No. 7 Morel A"A Farm _____

Continental Company

Morel


330 Ft. from N. Line

_____ Ft. from S. Line

_____ Ft. from E. Line

330 Ft. from W. Line

NW/C

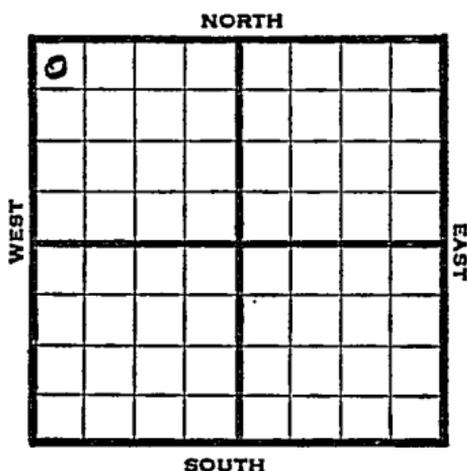

1947

Elev. 2246' REPORT

4/30

Location

5/7

RUR

5/13

"

5/20

Arb 3726
TD 3730'
5" @ 3726'
RUST

5/27

TD 3741'
1000 Acid
450' oil $\frac{1}{2}$ hrs.

6/4

Arb. 3726'
5" @ 3726'
1500 Acid.
Pump 435 oil and 195 W Pot
27.3 Gr.
TD 3741'

COMPLETED

Map No. 65 Sec. 14 Twp. 9 R. 21W

Well No. 7 Morel "A"

Continental Company

FIRST REPORT

Contractor

NW/C

330 Ft. from N. Line

_____ Ft. from S. Line

_____ Ft. from E. Line

330 Ft. from W. Line

SECTION PLAT

2			

Graham County

Location X

Rig up _____

Drilling and Remarks:

RECORD

Cased _____ in., _____ ft.

Sand _____

Gas _____

Oil _____

Total Depth _____

PRODUCTION

1st 24 hrs. Nat. _____

1st 24 hrs. after shot _____

Gas _____ Cu. Ft.

Dry Hole _____

Abandoned _____

Date

APR 30 1947 19

S. J. LEWIS Scout

Map No. 65 Sec. 14 Twp. 9 R. 21W

Well No. 7 Morel "A"

Continental Company

COMPLETE

Contractor

NW/C

E 12246
SECTION PLAT

330 Ft. from N. Line.

_____ Ft. from S. Line

_____ Ft. from E. Line

330 Ft. from W. Line

0			

Graham County

RECORD

Location _____

Cased _____ in., _____ ft.

Rig up _____

Sand _____

Drilling and Remarks:

Gas _____

Per 3726
5' @ 3726
1500 acid
Prod 485 oil 7
195W Per
27 3/4

Oil _____

Total Depth 197 4/8

PRODUCTION

1st 24 hrs. Nat. _____

1st 24 hrs. after shot _____

Gas _____ Cu. Ft.

Dry Hole _____

Abandoned _____

Date

JUN 4 1947 19

S. I. LEWIS Scout