



Sec. 14 Twp. 9 R. 21W

Well No. 5 Knipp Farm

Shell Company

Morel Pool


\_\_\_\_\_ Ft. from N. Line

330 Ft. from S. Line

\_\_\_\_\_ Ft. from E. Line

990 Ft. from W. Line

SE SW SE

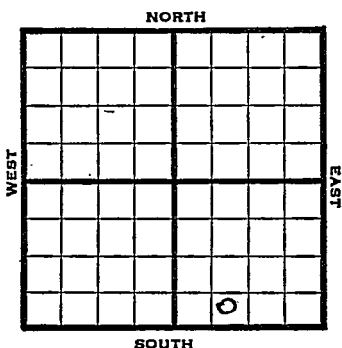

1948 Elev. 2278' REPORT

9/22	Location
9/29	Drlg 1758'
10/6	8" @ 1754' Drlg 3096'
10/13	Lansing 3458' - Simpson shale 3756' Drlg 3771'
10/19	Arb. 3779' TD 3844 4" @ 3843'
10/26	42 shots 3778-86 500 acid Swb 65 bbls oil / 130 # in 3 hrs.
11/3	"
11/10	PB 3804 - 36 shots 3778-85 500 acid Swb 145 bbls fluid 3 hrs. 46% W.
11/17	Arbückle 3779' 4" @ 3843' Perf. 1000 acid Echo Pot. 2359 oil & 15% W Gr. 30 TD 3844'

**COMPLETED**



