

KANSAS

Graham

Section 14 Township 9 Range 21WWell No. 8 KnippCompany ShellMorel Pool
NORTH

14

O

KANSAS

Graham

Sec. 14 Twp. 9 R. 21W ✓

Well No. #8 Knipp Farm

Shell Company

Morel Pool


 Ft. from N. Line

330' Ft. from S. Line

330' Ft. from E. Line

 Ft. from W. Line

SE SW

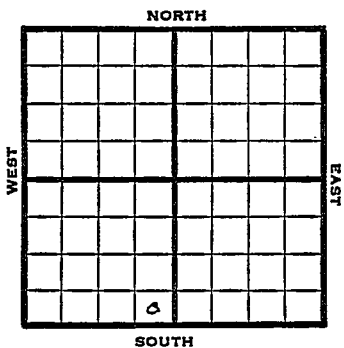

1948

Eli 2271' REPORT

11/23 Location
11/30 Drlg 1475'
12/8 8" @ 1724'
Drlg 2822'
12/15 Drlg 3613'
12/22 Lansing 3454'
Arbuckle 3762'
TD 3837
4" @ 3836'
35 shots 3761-67
Swb 150 bbls oil 5 hrs.
12/29 TD 3837'
Arb. 3762'
4" @ 3836'
Perf 500 acid
Depth Pot 3000 Oil
39³ Gr.
Comp

COMPLETED

Map No. _____ Sec. 14 Twp. 9 R. 21W


Well No. 8 Knipp

Shell _____ Company

FIRST REPORT _____ Contractor

SE SW

SECTION PLAT

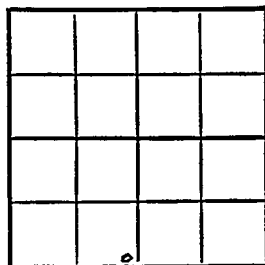

_____ Ft. from N. Line

330 Ft. from S. Line

330 Ft. from E. Line

_____ Ft. from W. Line

Graham County

Location X

Rig up _____

Drilling and Remarks:

RECORD

Cased _____ in., _____ ft.

Sand _____

Gas _____

Oil _____

Total Depth _____

PRODUCTION

1st 24 hrs. Nat. _____

1st 24 hrs. after shot _____

Gas _____ Cu. Ft.

Dry Hole _____

Abandoned _____

Date

NOV 23 1948

19

S. J. LEWIS

Scout

Map No. 65 Sec. 14 Twp. 9 R. 21W

Well No. 8 Knipp

Shell Company

COMPLETE Contractor

SE SW


E12271
SECTION PLAT

 Ft. from N. Line

330 Ft. from S. Line

330 Ft. from E. Line

 Ft. from W. Line

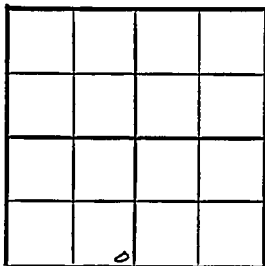

Graham County

Location

Rig up

Drilling and Remarks:

Cr 8762

4" C8836

Perf.

500000

Depth 300000

293

RECORD

Cased in., ft.

Sand

Gas

Oil /

Total Depth 2832

PRODUCTION

1st 24 hrs. Nat.

1st 24 hrs. after shot

Gas Cu. Ft.

Dry Hole

Abandoned

Date

DEC 29 1948

19

S. J. LEWIS

Scout