


KANSAS <sup>AG</sup> Graham

Section 14 Township 9 Range 21W

Well No. #4 A Morel

Company Continental et al

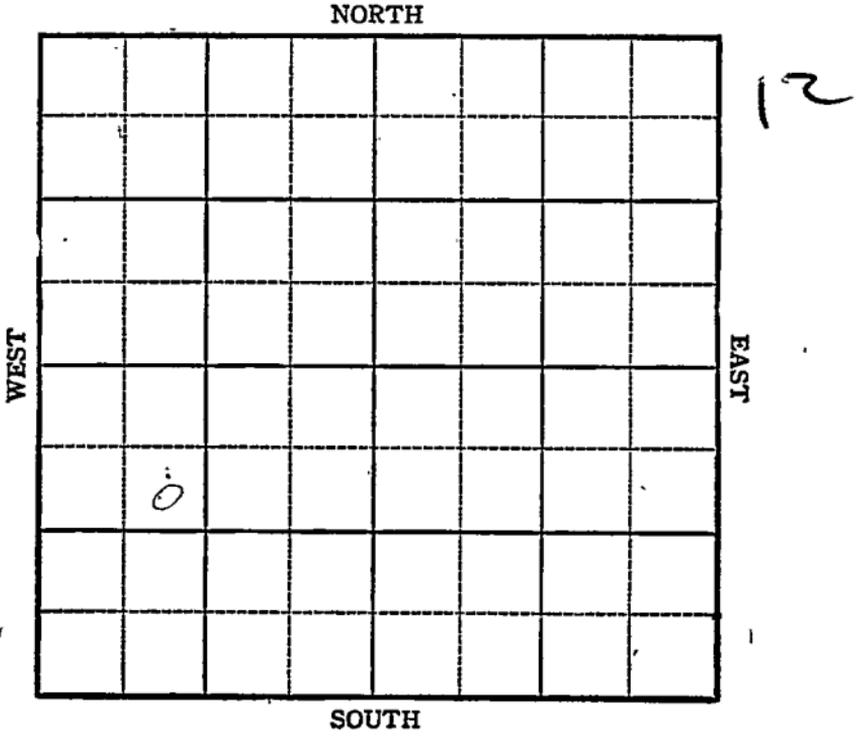

KANSAS

Sec. 14 Twp. 9 R. 21W

Well No. #4 A. Morel Farm

Continental et al. Company

Morel

NORTH

990 Ft. from N. Line


\_\_\_\_\_ Ft. from S. Line

\_\_\_\_\_ Ft. from E. Line

990 Ft. from W. Line

WEST

EAST

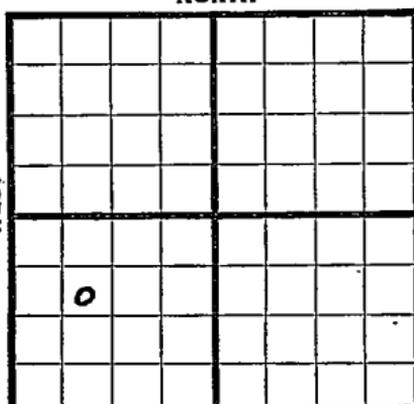

SOUTH

SE NW SW *Elev. 2269*

1944

REPORT

- 8/9 Loc.
- 8/16 Drk.
- 8/23 10" @ 241  
Drlg. 2255
- 8/30 Drlg. 3683
- 9/8 Arb 3765-71 TD  
6" @ 3766 RUST
- 9/13 Lans 3444  
2800' oil swb 200 oil in 2 hrs.
- 9/20 Arb 3765  
6" @ 3766'  
Echo Pot. 8200  
Max 3000  
Grav. 29.3  
TD 3771

COMPLETED

Pool Name MorelMap No. KANSAS Sec. 14 Twp. 9 R. 21WWell No. 4 A. MorelContinental etal. Company

## FIRST REPORT

Contractor

SE NW SW

## SECTION PLAT

990 Ft. from N. Line       Ft. from S. Line       Ft. from E. Line990 Ft. from W. Line


Graham CountyLocation XRig up       Drilling and Remarks:       

## RECORD

Cased        in.,        ft.Sand       Gas       Oil       Total Depth       

## PRODUCTION

1st 24 hrs. Nat.       1st 24 hrs. after shot       Gas        Cu. Ft.Dry Hole       Abandoned       

Date

AUG 9 1944 19       S. J. LEWIS Scout

Pool Name MOREL Pool

Map No. KANSAS Sec. 14 Twp. 9 R. 21W

Well No. 4 A. MOREL

Continental etal. Company

**COMPLETED** Contractor

SE NW SW


SECTION PLAT

990 Ft. from N. Line

\_\_\_\_\_ Ft. from S. Line

\_\_\_\_\_ Ft. from E. Line

990 Ft. from W. Line

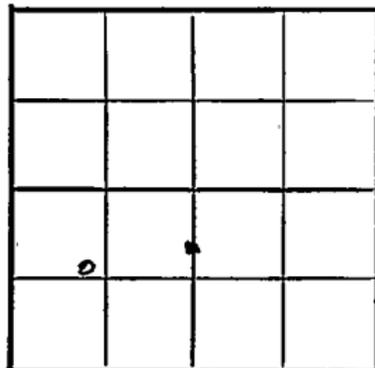

Graham County

Location \_\_\_\_\_

Rig up \_\_\_\_\_

Drilling and Remarks:

*Cu 43765*

*6" @ 3766.*

*Ecl 1200*

*Max 3000*

*293*

RECORD

Cased \_\_\_\_\_ in., \_\_\_\_\_ ft.

Sand \_\_\_\_\_

Gas \_\_\_\_\_

Oil \_\_\_\_\_

Total Depth 2221

PRODUCTION.

1st 24 hrs. Nat. \_\_\_\_\_

1st 24 hrs. after shot \_\_\_\_\_

Gas \_\_\_\_\_ Cu. Ft.

Dry Hole \_\_\_\_\_

Abandoned \_\_\_\_\_

Date

SEP 20 1944 19

S. J. LEWIS Scout