

TWH 7-F07 ✓

Graham

KANSAS

SECTION 14 TOWNSHIP 9 RANGE 22W

WELL NO. #1 Sandzen

COMPANY Fred. Pipe & Supply Co.

				NORTH	NE SE SW			
WEST								EAST
				SOUTH				

HOT FILE Graham KANSAS

SEC.

TWP.

R.

14

9 S

22 W

WELL NO.

1 Sandzen

FARM

COMPANY

Producers Pipe & Supply Co.

CONTRACTOR

Veedor Drlg.


Van Pool

_____ FT. FROM N. LINE

_____ FT. FROM S. LINE

_____ FT. FROM E. LINE

_____ FT. FROM W. LINE

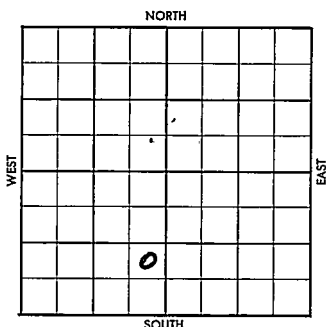

NE SE SW

SDX-FO (Lse S-12223)

1957

ELEVATION

2301' DF 2304' REPORT (TWH7-FO7) ✓

4/25

Arbuckle formation test appx 3900'

To be commenced by July 1, 1957

To be completed by September 1, 1957

(See copy FO Agt 4-25-57)

6/5

Location

(FR Tkt)

8/21

Comm. 6-30-57

8-5/8" @ 237/140

DST 3515-46' open 1 hr, rec 75' SOCMW

FP 35-50# BHP 790#

DST 3546-70', op 1 hr, 270' GIP, rec

60' HO & GCM + 60' med. OCM + 90'

froggy MCO. FP 60-125#. BHP 675#

DST 3569-88' op 1 hr, rec 15' SOCM

All press. Off

DST 3586-3609' open 1 hr, 90' gas,

rec 235' HO CM. FP 0-90#. IBHP 697#

FBHP 647# 30"

DST 3646-3710' open 1 hr rec 45' SOCM

FP Off BHP 377# 30"

DST 3705-15' open 1 hr rec 40' SOCM

FP 55-55# IBHP 535# 20". FBHP 1120# 30"

DST 3846-60' op 1 hr rec 25' med. OCM

FP Off IBHP 770#. FBHP 1090# 30"

RTD 3860' 5 1/2" @ 3848/150 WOCT

CO 3640' ? Perf 16/3611-15 No test

nat. S/10 BFPH 10% wtr. 8 hrs. POP

1957

8/21

(Information continued)

32.56 BOPD. Gravity 29°

Dops: Heeb 3483', Tr. 3510'

Lans. 3523' B KC 3728' Arb. 3856'

TD 3860'

COMPLETED

8/30 (Advised Contract Section- Comp.Oil)✓

County Graham Elev. _____
 Sec. 14 Twp. 9 Rge. 22W
 Company Prod. Pipe & Supply Co.
 FarmName Sandzen No. 1

TOPS	DEPTH	LOG	DATUM
Anb.			
Tr.			
H.			
Tr.			
Dg.			
BL.			
L.			
K.C.			
B.K.C.			
Ce.			
C.			
M.			
M.			
K.			
Mz.			
Me.			
V.			
S.			
S.			
A.			
R.			
Pe.			
G.			
TD.			

Loc. in Sec. _____

NE SE SW

Geol. _____

Contr. _____

Veedor Drl g.

Pool _____

Van

FIRST REPORT

JUN 5 '57

Date Comm. _____

Sunray (FO)

Location _____

Co.

Lse.

No.

Sec.

T.

R.

FORM 513 SUNRAY

2301 DE

County GrahamElev. 2304 RBSec. 14Twp. 9Rge. 22WCompany Prod. Pipe & Supply Co.

Gardzen

No. 1

TOPS	DEPTH	LOG	DATUM
Ant.			
TP.			
H.	3483		
Tc.	3510		
Dg.			
Bl.			
L.	3523		
K.C.			
BXC.	3728		
Ce.			
C.			
M.			
M.			
K.			
Mz.			
Ma.			
V.			
S.			
S.			
A.	3856		
R.			
Pe.			
G.			
TD.	3860	TW#7-FO	

Loc. in Sec.

NE SE SW

Geol.

Contr.

Veedor Drlg.

Pool

Van

COMPLETE

AUG 21 '57

Date Comm.

Sunray (FO)

Location. JUN 2 '57

JUN 19 '57

JUN 25 '57

WOR JUL 3 '57 X, ~~11/11/57~~ L-30-57

JUL 10 '57 878 237/140 TOPS DST

3515-46 up 1hr rec 75' 50CMW

FP 35-50 BHP 790 DST 3546-70

up 1hr 270' GIP rec 60' Ho 6' GCM

+ 60' Med 0CM + 90' Fr 999 MCO FP

60-125 BHP 675 DST 3569-88

JUL 17 '57 X up 1hr rec 15 50CM All

PRESS 0. DST 3586-3609 ~~up~~ 1 hr. 90'
 gas rec 235' HOCM FPO-90
 1BHP 697 FBHP 647/36" DST 3646-
 3710 ~~up~~ 1 hr. rec 45' 50CM FPO BHP
 377/30" DST ~~3716-17~~ 3705-15 ~~up~~
 1 hr. rec 40' 50CM FPO 55-55 1BHP
 535/20" FBHP 1120/36" ~~AKC~~ AKC
 3728 need top? A16 3856 DST 3846
 -60 ~~up~~ 1 hr. rec 25' Med 0CM
 FPO 1BHP 770 FBHP 1090/30"
 RTD 3860 5 1/2 @ 3848/150
 WOCT JUL 24 '57 X W.G. " " JUL 31 '57 X AUG 8 '57
 CO 3640? 16/ 3611-15 notst nat
 1 1/2 \$ 10 BEPH 1090 wtr 8 hrs
 P 1 AUG 14 '57 X AUG 21 '57 32.56 BOPD/24hrs
 P 2 w 18% 44" stroke/22 PM
 G 29" 1 1/4" Pump. wtr Pumped By
 Treater Siphon 1 1/2" in 375 Bbl tank
 Timon - 2' 8 1/2" @ end of test
 P