

Graham


KANSAS

SECTION 11 TOWNSHIP 9 RANGE 22 WWELL NO. #1 SandzenCOMPANY K & E Drlg. & Century Ref.

NORTH

WEST

EAST

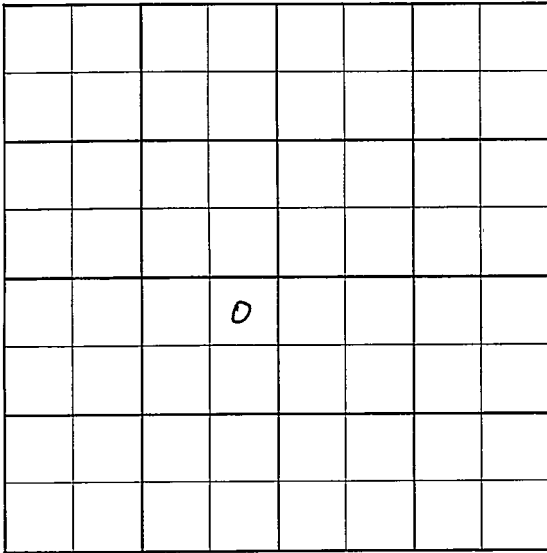

SOUTH

2-16 CO, FU 300' oil 1 hr., 40 min.

2-23 FU 1000' oil end of 7 hrs.
S/ $24\frac{1}{2}$ bo 7 hrs.
T & R

3-1 Putting on pump

3-8 P/100 bo, no wt, 24 hrs.

3-15 No report

3-22 No report

3-29 "

4-5 "

4-12 "

4-19 "

4-26 "

5-3 "

5/9 Comm. 1-20-56

8" @ 220/150

P/100 BO 24 hrs.

Comp. 150 BOPD. TD 3864'

Tops: Anh 1810', H. 3484', L. 3525'

A. 3856'

Log: H. 3484', BL 3513', L. 3526'

BKC 3740' A. 3856'

. . COMPLETED

5/21

Do not advise Contract Section.

See Ltr 3-15-56 from Contract Section.

County Graham Elev. _____
 Sec. 11 Twp. 9 Rge. 22W
 Company K & E Drlg. & Century Ref.
 Farm Name Sandzen No. 1

TOPS	DEPTH	LOG	DATUM	Loc. in Sec.
Anh.	<u>1810</u>			<u>NE NE SW</u>
TP.				
H.				
Tr.				
Dg.				
BL.				
L.				
K.C.				Geol. _____
B.K.C.				Contr. _____
Ce.				<u>K & E Drlg.</u>
C.				
M.				Pool _____
M.				<u>Wildcat</u>
K.				
Mz.				
Me.				
V.				
S.				
S.				
A.				
R.				
PE.				
G.				
T.D.				

FIRST REPORT

JAN 25 1956

Date Comm. 1-20-56 Sunray MCOC farmout
8th @ 220/150 drlg. 3005 NCRA - DIT

County Graham Elev. 2300
 Sec. 11 Twp. 9 Rge. 22W
 Company K & E Drlg. & Century Ref.
 FarmName Sandzen No. 1

TOPS	DEPTH	LOG	DATUM	Loc. in Sec.
Anh.	1810			NE NE SW
TP.				
H.	3484	3484		
Tr.				
Dg.				
BL.		3513	1213	
L.	3525	3526	1226	Geol.
K.C.				Contr.
B.K.C.		3740	1440	K & E Drlg.
Ce.				Pool
C.				Van
M.				
M.				
K.				
Mz.				
Me.				
V.				
S.				
S.				
A.	3856	3856	1556	COMPLETE
R.				
PE.				
G.				
TD.	3864			

Date Comm. 1-20-56 MAY 9 1956

8" @220/150 DST 3552-70 open 1½ hr.

rec. 30' wtr. 150' ocm 240' hocm

240' mco 1015/30" DST 3610-29

open 1 hr. rec. 60' oil 540' ocs w

2 40' sw 1280# DST 3851-56

open 1 hr. rec. 6' mud DST 3859-64

open 1 hr. rec. 250' oil 60' muddy oil

60' ocm 1110# TD 3864 5½" @ 3858

CO FU 300' oil 1 hr. 40 min.

FU 1000' oil end of 7 hr. S/ $24\frac{1}{2}$ bo

7 hr. P/- 100 bo. 24 hr.

Comp. 150 bopd .

M. M.

MAY 21 1956