


Section 14 Township 9 Range 22W

Well No. #4 Sandzen

Company Wood River Oil Co.

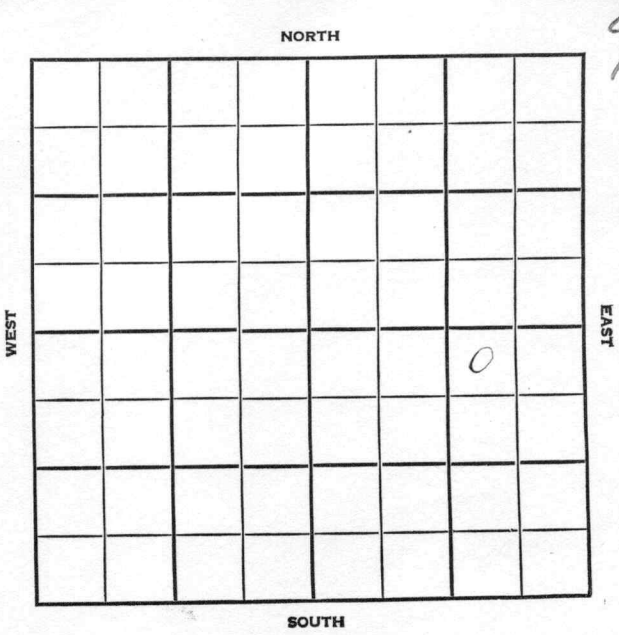

County Graham Elev. _____
 Sec. 14 Twp. 9 Rge. 22W
 Company Wood River Oil Co.
 Farm Name Sandzen No. 4

TOPS	DEPTH	LOG	DATUM
Anh.			
Tp.			
H.			
Tr.			
Dg.			
BL.			
L.			
K.C.			
B.K.C.			
Ce.			
C.			
M.			
M.			
K.			
Mz.			
Mq.			
V.			
S.			
S.			
A.			
R.			
PE.			
G.			
T.D.			

Loc. in Sec. NW NE SE
 Geol. _____
 Contr. _____
Gab-Jones Tools
 Pool Van

FIRST REPORT
 DEC 5 1956

Date Comm. MIRT

Co.
 No.
 Sec.
 T.
 R.

Rig to Ellis 300310

FORM 513 SUNRAY

County Graham Elev. 2294
 Sec. 14 Twp. 9 Rge. 22W
 Company Wood River Oil Co.
 Farm Name Sandzen No. 4

TOPS	DEPTH	LOG	DATUM	Loc. in Sec.
Anh.				NW NE SE
Tr.				
H.	3478			
Tr.	3502			
Dg.				
BL.				
L.	3517			Geol. <u>Gill</u>
K.C.				Contr.
B.K.C.				<u>Gab-Jones Tools</u>
Ce.				
C.				
M.				
M.				Pool
K.				<u>Van</u>
Mz.				
Mo.				
V.				
S.				
S.				
A.	3845 3843	3841		<div style="border: 1px solid black; padding: 5px; text-align: center;"> <p>COMPLETE</p> <p>6</p> <p>JAN 9 '57</p> </div>
R.				
PE.				
G.				
TD.	<u>3845</u> 3852			

Date Comm. MIRT DEC 12 '56 12-5-56 858

222 17 2655 DEC 19 '56 Tops DST
3518-40' up thru sec 7' Md BHP
420/20" DST 3560-75' up thru sec
240' MCO FP0-100 BHP 860/20"
DST 3592-3617' up thru sec 530' SW
FP0-380 BHP 720/20" DST 3680
-3710' up thru sec 40' 50CM FP 0
BHP 0/20" Arb 3843 RTD ~~3852~~
R09 Pipe @ 3245

DEC 26 '56

Back Tops H6 3478 TR 3502
 correct APC To ~~3841~~ 3841 RTD
 3845 5 1/2 3843 no Log
 Co 3845 550 N went behind
 pipe sqd op. Hole co. JAN 2 '57
 Co DD 3848 1/2 1/2 Lost 6d.
 DD 3859 TD N.S. PB 3580
 48/ 3554-62 950 gal acid
 \$ 10 Bopd no/w no time
 T&R to Pat ~~2 1/2~~ X
 PH P 222 Bopd no/w
 L59 PF. 3554-62
~~PH~~ TD 3859
 PBTD 3580