

Section 14 Township 9 Range 22W

Well No. #1 Van Loene

Company N C R A

NORTH

				0			

2

WEST

EAST

SOUTH

Sec. 14 Twp. 9 R. 22W

Well No. #1 Van Loene Farm

N C R A Company

Barnett - Contr. Contractor

Wildcat


330' Ft. from N. Line

_____ Ft. from S. Line

_____ Ft. from E. Line

330' Ft. from W. Line

NW NW NE

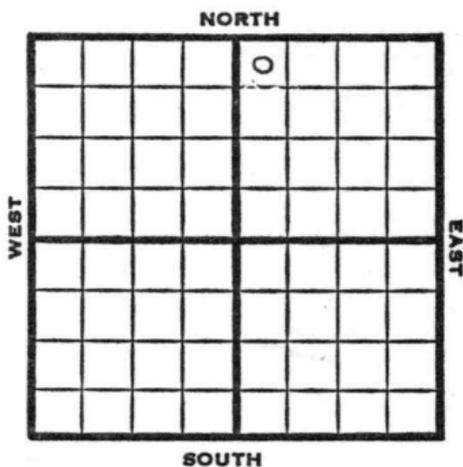

1951

Elev. 2260' REPORT

2/7

RUR

2/21

Spud 2-6-51

D & A

TD 3886

8" @142

Anhy 1760

Heeb. 3458

Lans. 3497

DST 3525-43 open 1½ hr. rec. 1570' sw

DST 3566-3611 open 1½ hr. rec. 30' sw

Arb. 3836-86 TD

D & A

ABANDONED

