


Section 14 Township 9 Range 22 W

Well No. #1 Van Loenen

Company N C R A

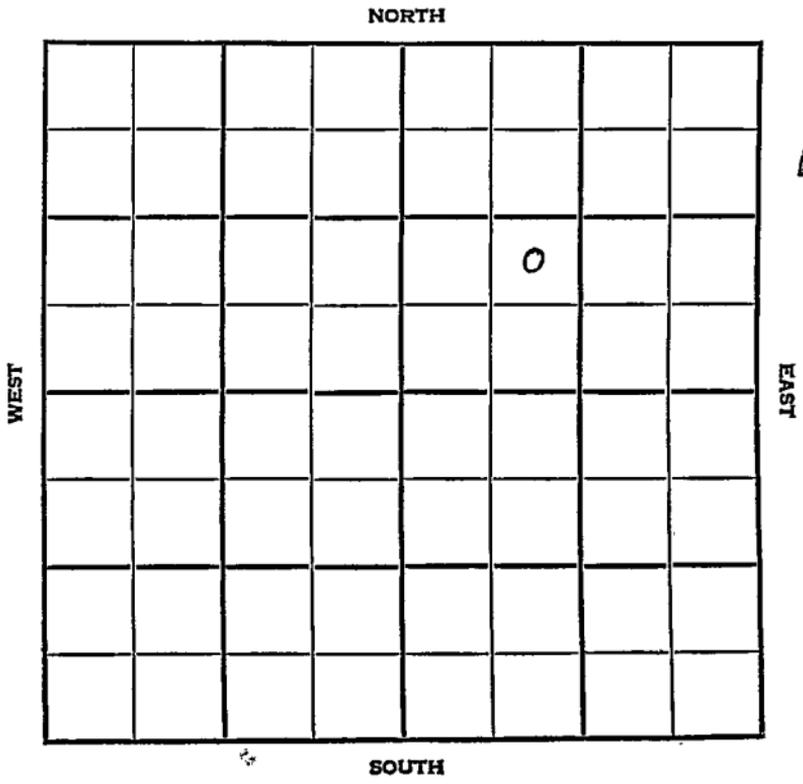

County Graham Elev. _____
 Sec. 11 Twp. 9 Rge. 22W
 Company N O R A
 Farm Name Van Loenen No. 4

TOPS	DEPTH	LOG	DATUM	Loc. in Sec.
Anb.				NE SW NE
Tp.				
H.				
Tr.				
Dg.				
Bl.				
L.				Geol. _____
K.C.				Contr. _____
B.K.C.				<u>Barnett</u>
Ce.				Pool _____
C.				<u>Van</u>
M.				
M.				
K.				
Mz.				
Mq.				
V.				
S.				
S.				
A.				
R.				
PE.				
G.				
T.D.				

MAR 7 1956
 FIRST REPORT


Date Comm. 3-3-56
8" @ 211/150 WOC

[Handwritten signature]

Co.
Lse.
No.
Sec.
T.
R.

County Graham Elev. 2270
 Sec. 14 Twp. 9 Rge. 22W
 Company N C R A
 Farm Name Van Loenen No. 4

TOPS	DEPTH	LOG	DATUM
Anh.			
Tp.			
H.	<u>3448</u>		
Tr.	<u>3478</u>		
Dg.			
Bl.			
L.	<u>3492</u>		<u>1272</u>
K.C.			
B.K.C.			
Ce.			
C.			
M.			
M.			
K.			
Mz.			
Me.			
V.			
S.			
S.			
A.	<u>3824</u>		<u>1554</u>
R.			
PE.			
G.			
T.D.	<u>3830</u>		

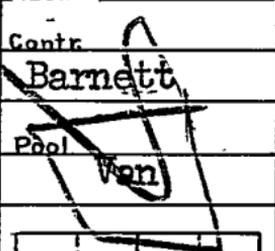Loc. in Sec. NE SW NE
 Geol. _____
 Contr. Barnett
 Pool Van

 COMPLETE

Date Comm. 3-3-56 APR 25 1956
8" @ 214/150 DST 3531-37 open 1 hr.
2000' gip rec. 335' clean oil.
100' muddy oil '950/20" DST 3549-56
open 1 hr. rec. 20' ocwm - 140/20"
DST 3579-84 open 1 hr. rec. 120' gip
56' muddy oil 10' muddy wtr. 1260/20"
DST 3619-32 open 1 hr. rec. 75' hocm
1240/20" DST 3650-62 open 1 hr.

OVER

rec. 2050' gip 900' clean oil 1200/20"
DST 366 1/4-78 open 1 hr. rec. 30' hocom
1070/20" DST 318 1/4-3503 open 1 hr.
rec. 140' ho & gcm 1130/20" 5 1/2" @ 3826
CO to 3830 2 goph 4 hr. 8/ 3826-30
reperf/ 8/ 3826-30 1 goph 2 hr.
250 A S/ 57 bo 13 hr.
Comp. 159 bopd

R. G.

MAY 4 1956