


Graham

KANSAS

SECTION 14 TOWNSHIP 9 RANGE 22W

WELL NO. #6 Van Loenen

COMPANY NCRA

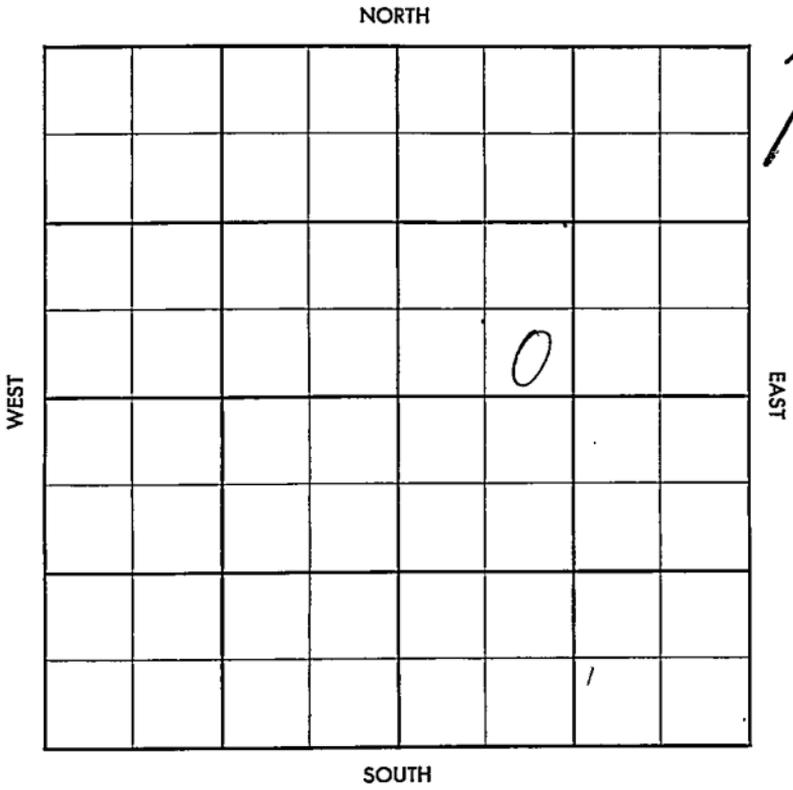

County Gramm Elev. 2255
 Sec. 71 Twp. 9 Rge. 22W
 Company N C R A
 FarmName Van Loenen No. 6

TOPS	DEPTH	LOG	DATUM	Loc. in Sec.
Anh.	1750			SE SW NE
TP.				
H.				
Tr.				
Dg.				
BL.				
L.				Geol.
K.C.				Contr.
B.K.C.				Barnett
Ce.				Pool
C.				Van
M.				<div style="border: 1px solid black; padding: 5px; display: inline-block;"> WEST REPORT DEC 2 '56 </div>
M.				
K.				
Mz.				
Me.				
V.				
S.				
S.				
A.				
R.				
Pe.				
G.				
T.D.				

Date Comm. 12-7-56
8" @ 247/150 drlg. 2065

[Handwritten signature]

Co.

Lse.

No.

Sec.

T.

R.

Co.

Sec.

No.

Sec.

T.

R.

County Graham Elev. 2255
 Sec. 14 Twp. 9 Rgs. 22W
 Company N C R A
 FarmName Van Loenen No. 6

TOPS	DEPTH	LOG	DATUM	Loc in Sec.
Anh.	1750			SE SW NE
TP.				
H.	3429			
Tr.				
Dg.				
Bl.				
L.	3469			Geol.
K.C.				Contr.
B.K.C.	3683			Barnett
Ce.				Pool
C.				Van
M.				COMPLETE
M.				
K.				
Mz.				
Me.				
V.				
S.				
S.				
A.	3802	3802		
R.				
PE.				
G.				
TD.	3805			JAN 23 '57

Date Comm. 12-7-56
8" @ 247/150 drlg. 206" Tops DST
3470-81 op 1 hr. rec 40' HOE' GCM
+90' Mdy oil + 270' clean oil gran
39° FPO-140 1BHP 1230 FBHP
1120/20" BKC 3683 DST in Marm
20 no top DST 3704-25 op 1 hr
rec 55' 50CM FPO BHP 165/20"
Arb 3808 RTD 3805^{No Log} 5 1/2 @ 3803
WACT

DEC 28 '56

1 CO 3805 TD \$ 5 Baph 170/w
 2 hrs 1/19 \$ 20 BFph (20% wts)
 3 hrs GRNL P.B 3720 16/3568
 -72 N.S. ~~12/3556-59~~ 550
 12 \$ 105 B0 170/w 5 hrs TER
 TO POP

JAN 2 '57 wo tst.

JAN 8 '57 X W.O.

5+ tst JAN 16 '57

JAN 23 '57 Ph P. 141 Bopd +
 5% wts grass 36°