

Graham

KANSAS

SECTION 14 TOWNSHIP 9S RANGE 24W

WELL NO. #1 Kline


COMPANY Francis O&G & Kaiser

NORTH

*Q 1/2 SW NW
C SW NW*

WEST

EAST

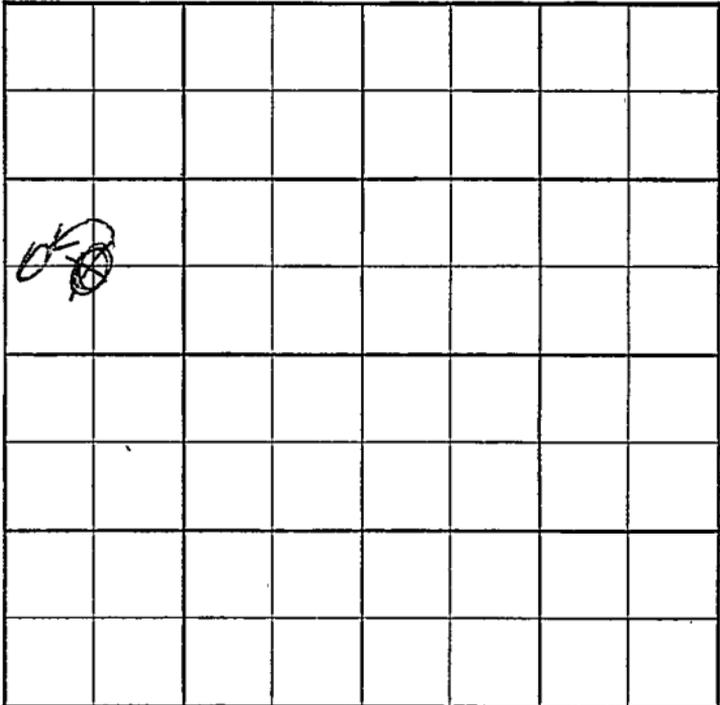

SOUTH

~~Holley~~~~S~~

County Graham Elev. 2485 RB
 Sec. 14 Twp. 9 Rge. 24W
 Company Francis O. & G. and Kaiser
 Farm Name Kline No. 1

TOPS	DEPTH	LOG	DATUM
Anh.			
Tp.			
H.			
Tr.			
Dg.			
B.L.			
L.			
K.C.			
B.K.C.			
Ce.			
C.			
M.			
M.			
K.			
Mz.			
Mq.			
V.			
S.			
S.			
A.			
R.			
Pf.			
G.			
T.D.			

Loc. in Sec. _____


G SW NW

Geol. _____

Contr. _____

Armer H-30

Pool _____

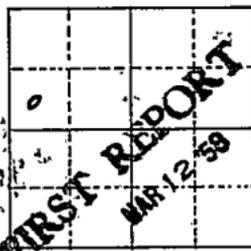Holley SE

Date Comm. 3/8/58 (Magnolia-FO)
 8" @ 210 w/150, Drlg. 2872

Co.

Lse.

No.

Sec.

T.

R.

Twp X Pool Holly

Co. X Facet 5

CORRECTION

S-513/B

County Graham Elev. 2485 RB 24030
 *Sec. 14 Twp. 9 Rge. 24W
 Company Francis O. & G. and Kaiser
 Farm Name Kline No. 1

TOPS	DEPTH	LOG	DATUM
Anh.	<u>2132</u>		
Tr.			
H.	<u>3788</u>		
Dg.			
B.L.			
L.	<u>3829</u>		
K.C.			
B.K.C.	<u>404B</u>		
Ce.			
C.			
M.			
M.			
K.			
Mz.			
Mq.			
V.			
S.			
A.			
R.			
Pf.			
G.			
T.D.	<u>4077</u>		

Loc. in Sec. SW NW
C 2 1/2 SW NW

Geol. _____
 Contr. _____
 Armer H-30
 Pool _____
 Holley SE

ABANDONED
MAR 27 1958

Date Comm. 3/8/58 (Magnolia-FO)
8" @ 210 w/150, Drlg. 2872 MAR 19 58 DST
3848-71 60" 220' SW 280' SOCSW
FP 130-280 BHP 1320/20" DST
3960-95 60" 10'M all p... 0
DST 3961-4016 120" 60'M 95'
V50CM FPO-245 BHP 410/20" @
DST 4008-77 40" 20'M FPO BHP
395/20" no log MAR 25 58

DOA