


Section 14 Township 9 Range 40W

Well No. #1 Riley

Company Slosson

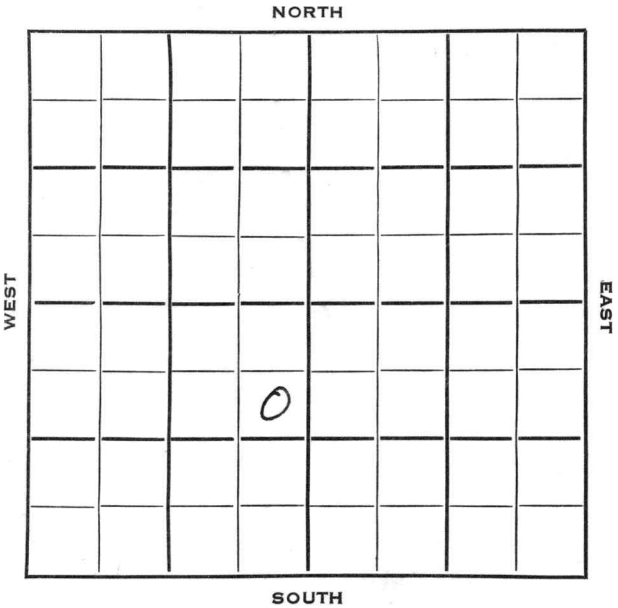

Sherman

KANSAS
HOW

Sec. 14 Twp. 9 R. 40W

Well No. #1 Riley Farm

Slosson Company

Wycoff Contractor

Wildcat


990 Ft. from N. Line

Ft. from S. Line

330 Ft. from E. Line

Ft. from W. Line

SE NE SW

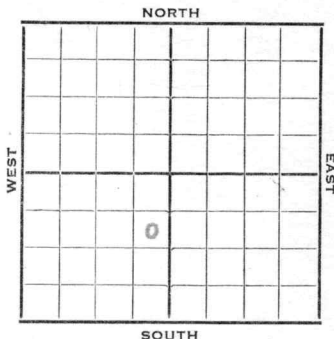

1953

Elev. - 3744 REPORT

7/14 Spud 7-12-53

10" @ 220'

7/22 Drlg. 2146'

7/29 Drlg. 4027'

8/5 Top 4050, Heeb 4327, Lans 4359, SSO
4430-41

Drlg. 4503'

8/12 Drlg. 5095'

8/19 Spud 7-12-53 D & A TD 5316

10" @ 320 Top 4046 Heeb 4356

Lans 4390 B KC 4800 Marm 4841

Cherokee 5120 Miss. 5230

TD 5316

D & A

ABANDONED

J. G. McGEHEE

County Sherman State KansasSec. 14 (Blk.
Twp.) 9 (Sur.
Rge.) 4 OW Map No.Operator SlossonWell No. 1 Farm RileyElev. Location SE NE SW990 Ft. From N Line SW330 Ft. From E Line Quarter1st. ReportCompletion AUG 19 1953Remarks WildcatWycoff - Contr.Spudding Date 7-12-53Drig. Data D & A TD 531610" @ 320 Top. 4046 Heeb. 4356Lans. 4390 B KC 4800 Marm. 4841Cherokee 5120 Miss. 5230 TD 5316D & A

J. G. McGEHEE