


Section 15 Township 9 Range 15 W

Well No. # 1 Finnesy

Company Nate Appleman et al

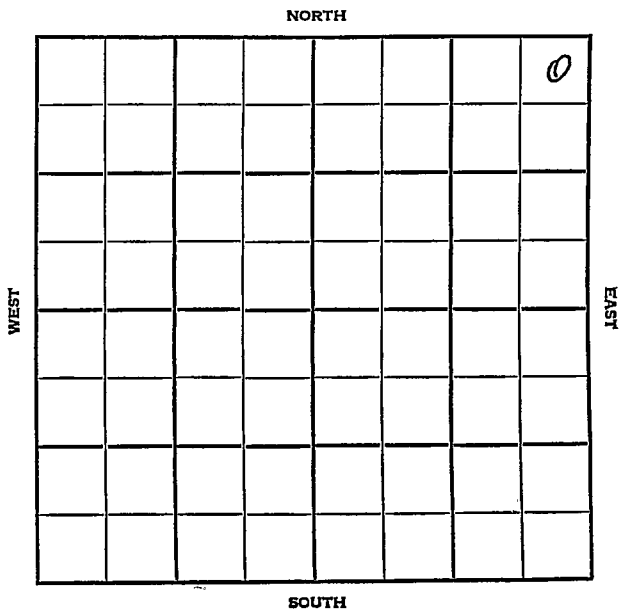

Osborne KANSAS


SEC. 15 TWP. 9 R. 15W

WELL NO. I Finnesy FARM
COMPANY

CONTRACTOR Nate Appleman et al

Trans-Era
Wildcat

330 Ft. from N. Line
Ft. from S. Line
330 Ft. from E. Line
Ft. from W. Line

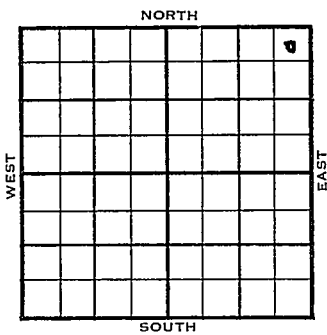

NE NE NE

Superior - AC & DHM

1955 ELEVATION 2012' DF 2014^{REPORT} KB

3/16 Spud 3-14-55
8" @ 194', WOC

3/30 Spud 3-14-55
D & A
TD 3935'
8" @ 194'
Top 2945', Heeb 3178' Tor. 3199'
KC 3227', B KC 3498' Cong. 3641',
Viola. 3688', Simp 3836' Arb. 3885'
TD 3935'
D & A

ABANDONED

