FORM 51 10M 8-47

KANSAS


Rooks

Section 15 Township 9 Range 16W

Well No. 1 Casey

Company ~~Cities Service~~

Leton

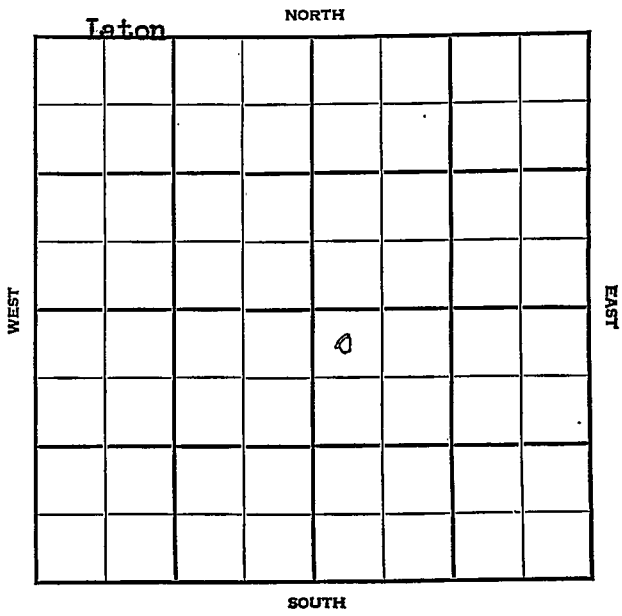

FORM 252-A
5M 12-45 PETROL

KANSAS

Rooks

Sec. 15 Twp. 9 R. 16W

Well No. #1 Casey Farm

Cities Service Company

Laton Pool


330' Ft. from N. Line

_____ Ft. from S. Line

_____ Ft. from E. Line

330' Ft. from W. Line

NW SE

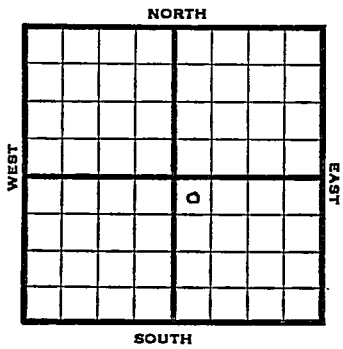

1948	Elev. 2104' REPORT
3/10	Location
3/17	Surface hole.
3/24	8" @ 248' Drlg. 2125'
3/31	Drlg. 3515'
4/7	Lans. 3270' BKC 3514' Simp 3691' Arbuckle 3714' TD 3730'

ABANDONED

Form 26—200 Bks.—1-48—Palace

Kansas

Laton Pool

Map No. _____ Sec. 15 Twp. 9 R. 16W


Well No. 1 Casey

Cities Service Company

FIRST REPORT Contractor

NW SE

SECTION PLAT

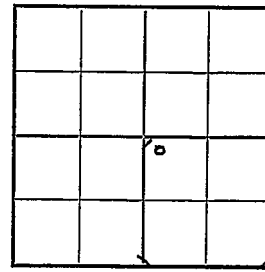

330 Ft. from N. Line

_____ Ft. from S. Line

_____ Ft. from E. Line

330 Ft. from W. Line

Rooks County

Location x

Rig up _____

Drilling and Remarks:

RECORD

Cased _____ in., _____ ft.

Sand _____

Gas _____

Oil _____

Total Depth _____

PRODUCTION

1st 24 hrs. Nat. _____

1st 24 hrs. after shot _____

Gas _____ Cu. Ft.

Dry Hole _____

Abandoned _____

Date

MAR 1 0 1948 19 S. J. LEWIS Scout

Form 26—200 Bks.—1-48—Palace

Laton Pool

Kansas

Map No. 64 Sec. 15 Twp. 9 R. 16W

Well No. 1 Casey


Cities Service Company

ABANDONED Contractor

NW SE

El. 2104

SECTION PLAT

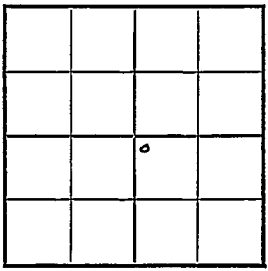

330 Ft. from N. Line

Ft. from S. Line

Ft. from E. Line

330 Ft. from W. Line

Rooks County

Location

Rig up

Drilling and Remarks:

Lans 3270
BKC 3514
Sing 3691
RTD 3714

RECORD

Cased in., ft.

Sand

Gas

Oil

Total Depth 3730

PRODUCTION

1st 24 hrs. Nat.

1st 24 hrs. after shot

Gas Cu. Ft.

Dry Hole

Abandoned

Date

APR 7 1948 19 S. J. LEWIS Scout