

KANSAS


Rooks

FORM 51 5M 4-41 PETROL

Section 15 Township 9 Range 16-W

Well No. #2 Tatkenhorst "B"

Company Krueger et al

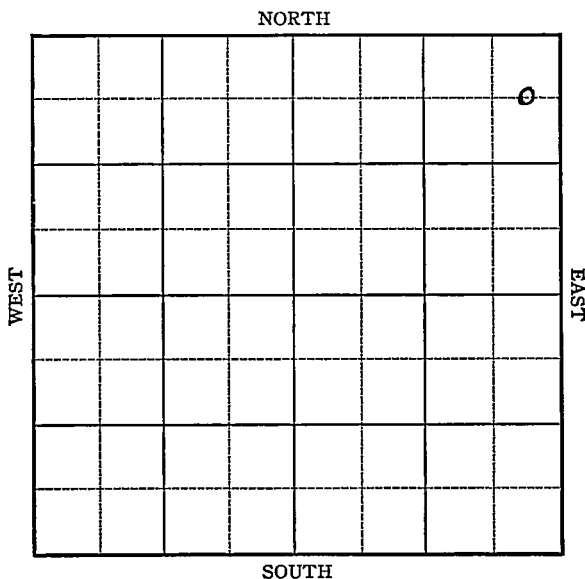


Sec. 15 Twp. 9 R. 16-WWell No. #2 Tatkenhorst "B" FarmKrueger et al Company

(Laton)

660 Ft. from N. Line Ft. from S. Line330 Ft. from E. Line Ft. from W. Line

Elev. 2092

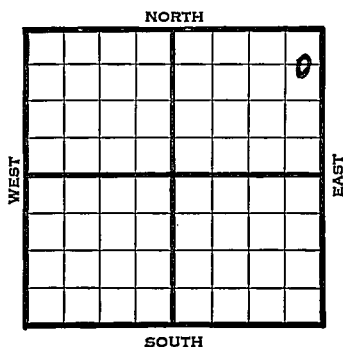

1941	REPORT
6/25	1800' SD.
7/3	Drlg. 3118'
7/10	S.O. 3235-41' & 3263-70' T.D.
	5" - 3263' RUST.
7/17	Lans. 3218-70' T.D. 5" - 3263'
	RUST.
7/24	# " " "
7/31	15 shots 3231-41 Testing.
8/7	4000 acid swab 35 oil in 8 hrs.
8/15	T.D. 3298 800' oil in hole
	Will acidize.
8/20	Lans. 3218'
	5" - 3263'
	T.D. 3298'
	15 shots 3231-41'
	10,000 acid.
	Potential 905 bbls. & pump.
	38. Gravity
	COMPLETED

Map No. 68 Sec. 15 Twp. 9 R. 16WWell No. 2 Tatkenhorst "B"Krueger etal

Company

Contractor

FIRST REPORT

C E L N E N E

660 Ft. from N. Line Ft. from S. Line330 Ft. from E. Line Ft. from W. Line**SECTION PLAT**

			o

LATON POOL

RECORDLocation Cased in., ft.Rig up Sand Drilling and Remarks: Gas 1800' S.D.Oil Total Depth **PRODUCTION**1st 24 hrs. Nat. 1st 24 hrs. after shot Gas Cu. Ft.Dry Hole Abandoned

Date

JUN 25 1941 19S. J. LEWIS

Scout

KANSAS

Map No. 64 Sec. 15 Twp. 9 R. 16WWell No. 2 Tatkenhorst "B"Krueger etal

Company

COMPLETED

Contractor

SECTION PLAT

C E L NE NE

660 Ft. from N. Line Ft. from S. Line330 Ft. from E. Line Ft. from W. Line

LATON POOL

			0

Location Rig up

Drilling and Remarks:

Lane 32185" @ 326315 shot to 3221-4110000 acw/cPump. 905 P.M.380 Gr.

RECORD

Cased in., ft.Sand Gas Oil Total Depth 3298

PRODUCTION

1st 24 hrs. Nat. 1st 24 hrs. after shot Gas Cu. Ft.Dry Hole Abandoned

Date

AUG 20 1941

19

S. I. LEWIS Scout