

Section 15 Township 9 Range 17W

Well No. 1 Carmichael

Company Brunson Drlg

Nyra
NORTH

WEST	8							

EAST

SOUTH

Sec. 15 Twp. 9 R. 17W ✓

Well No. #1 Carmichael Farm

Brunson Drlg. Company


Nyra Pool

330' Ft. from N. Line

_____ Ft. from S. Line

_____ Ft. from E. Line

330' Ft. from W. Line

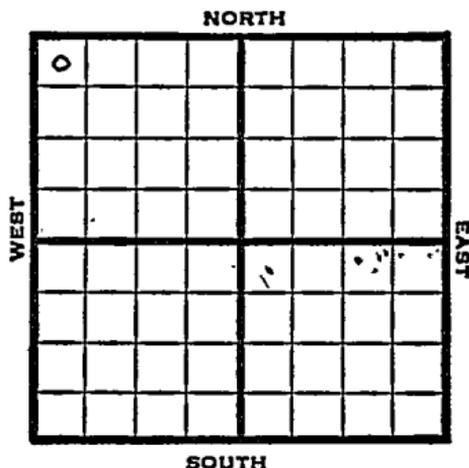

NW/C

1949	Elev ^{2072'} 2070' REPORT
3/16	RUR
3/23	8" @ 126' Drlg. 2560'
3/30	Lansing 3220' Arb. 3496' TD 3498' 5" @ 3496'
4/6	"
4/12	TD 3500' 500 acid Swb 5 bbls oil PH
4/20	"
4/27	"
5/4	TD 3500' Arb. 3496' 5" @ 3496' 500 acid Pump 50 Oil Pot 28° Gr. Gomp
COMPLETED	

Kansas

Map No. _____ Sec. 15 Twp. 9 R. 17W

Well No. 1 Carmichael

_____ Brunson Drlg. _____ Company

_____ FIRST REPORT _____ Contractor

NW/C

SECTION PLAT

330 Ft. from N. Line

_____ Ft. from S. Line

_____ Ft. from E. Line

330 Ft. from W. Line

o			

Rooks County

RECORD

Location _____

Cased _____ in., _____ ft.

Rig up _____

Sand _____

Drilling and Remarks:

Gas _____

Oil _____

R U R

Total Depth _____

PRODUCTION

1st 24 hrs. Nat. _____

1st 24 hrs. after shot _____

Gas _____ Cu. Ft.

Dry Hole _____

Abandoned _____

Date

MAR 16 1949 19

S. J. LEWIS

Scout

Map No. K. 64 Sec. 15 Twp. 9 R. 17W

Well No. 1 Carmichael

Brunson Drlg. Company

COMPLETE

Contractor

NW/C

E1. 2072
SECTION PLAT

330 Ft. from N. Line

 Ft. from S. Line

 Ft. from E. Line

330 Ft. from W. Line

0			

Rooks County

Location _____

Rig up _____

Drilling and Remarks:

Card 3496
5" @ 3496
5800 ft. oil
Prod 50 oil @ 28
2800

RECORD

Cased _____ in., _____ ft.

Sand _____

Gas _____

Oil _____

Total Depth 3580

PRODUCTION

1st 24 hrs. Nat. _____

1st 24 hrs. after shot _____

Gas _____ Cu. Ft.

Dry Hole _____

Abandoned _____

Date

MAY 4 1949 19

S. J. LEWIS

Scout