

DX 78-1


Rooks

KANSAS

Section 15 Township 9 Range 18 W

Well No. # 2 Meier

Company Grant Oil

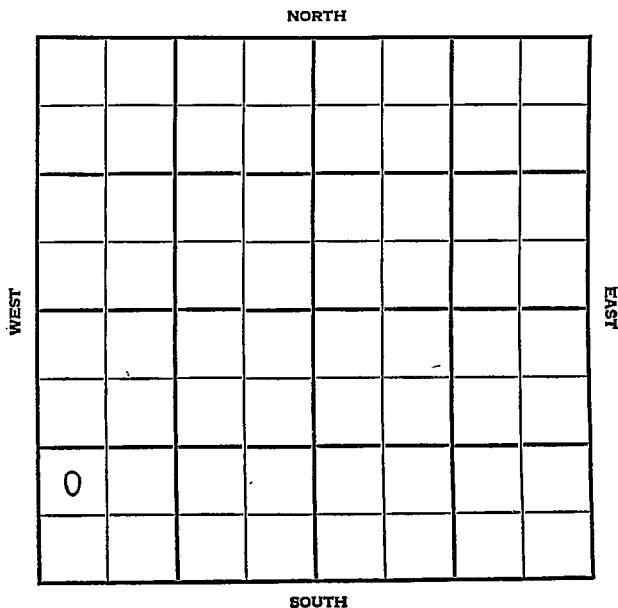

Rooks

KANSAS

SEC.	TWP.	R.
15	9	18 W

WELL NO.

2 Meier

FARM

COMPANY

Grant Oil

CONTRACTOR

Empire Drlg.

Paradise Creek Pool

NORTH

_____ Ft. from N. Line

990 _____ Ft. from S. Line

_____ Ft. from E. Line

330 _____ Ft. from W. Line

WEST

EAST

0

SOUTH

NW SW SW

ELEVATION	REPORT
1954	2159'

8/11

Spud 8-6-54
 9" @ 184' Anhy 1486
 Drlg. 2485'

8/18

Spud 8-6-54
 D&A
 TD 3620'
 9" @ 184'
 Anhy 1486', Top 3080', Heeb 3292',
 KC 3332', Arb. 3578'
 TD 3620'
 DST 3474-94', opn 2hrs., rec. 1065'
 SW, 510#
 DST 3577-84', opn 45", rec. 4' mud
 DST 3580-90', opn 1/2 hrs., rec. 50' mud,
 100#
 D&A

ABANDONED

County _____ Rooks _____ State **Kansas**

Sec. 15 (Blk. Twp.) 9 (Sur. Rge.) 18W Map No. _____

Operator Grant Oil

Well No. 2 Farm Meier

Elev. 2159 Location NW SW SW

990 Ft. From S Line SW

330 Ft. From W Line Quarter

1st. Report _____

Completion AUG 18 1954

Remarks Paradise Creek Pool

Empire Drlg. - Contr.

Spudding Date 8-6-54

Drlg. Data D & A TD 3620

9" @ 184 Anhy 1486 Top. 3080

Heeb. 3292 KC 3332 Arb. 3578

TD 3620 DST 3474-94 open 2 hr.

Rec. 1065' sw 510# DST 3577-84

open 45 min. Rec. 4' mud DST 3580-90

open 1/2 hr. Rec. 50' mud 100#

D & A

FABEN GILSTRAP