


SECTION 15 TOWNSHIP 9S RANGE 18W

WELL NO. #2 Toelkes

COMPANY Cook & Galloway

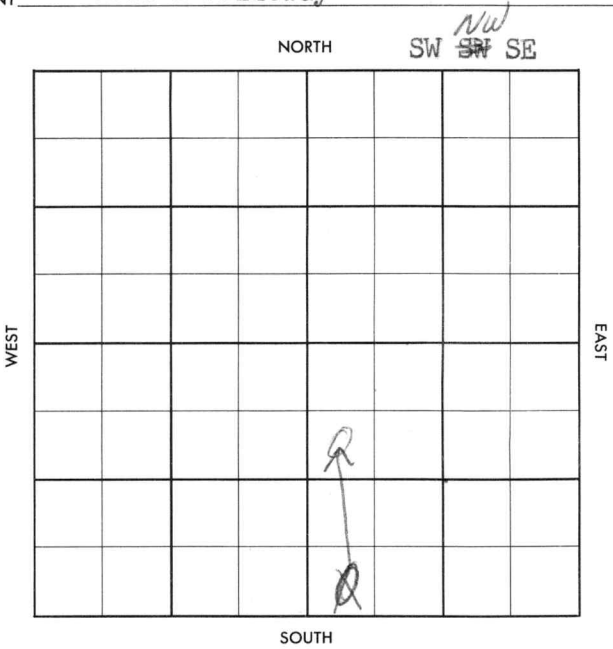

CORRECTION

FORM 513 SUNRAY

County Rooks Elev. 2077 DF
 Sec. 15 Twp. 9S Rge. 18W
 Company Cook & Galloway
 Farm Name Toelkes No. 2

TOPS	DEPTH	LOG	DATUM
Anh.	<u>1410</u>		
Tr.	<u>X 3226</u>		
H.			
Tr.			
Dg.			
Bl.			
L.	<u>3268</u>		
K.C.			
B.K.C.	<u>3491</u>		
Ce.			
C.			
M.			
M.			
K.			
Mz.			
Mq.			
V.			
S.			
S.			
A.	<u>3531</u>		
R.			
Pe.			
G.			
T.D.	<u>3563</u>		

Loc. in Sec.
SW SW SE
SW NW SE

Geol. Bab Aitken

Contr.
 Co. Tools

Pool
 Paradise Creek

ABANDONED
 SEP 18 57

Date Comm.

Location SEP 11 57 X MTR Spud 9-6-57
8 5/8" 177/140 ANH 1410 #2585
#2585 SEP 18 57 X TOPS #3350
DST 3532-38 20" 4' md BHP 153

D & A