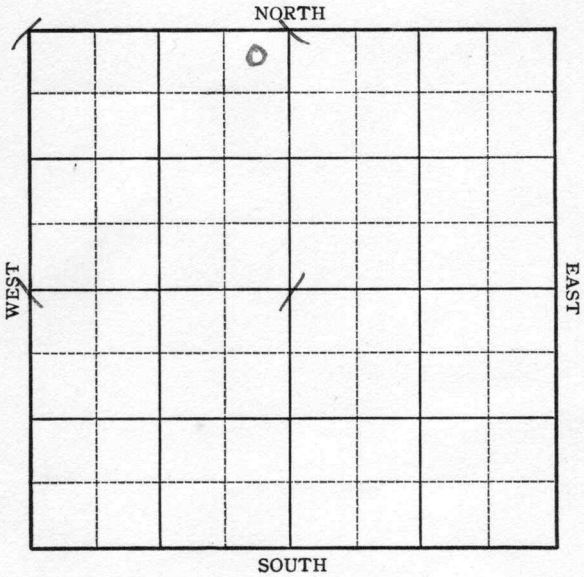


Section 15 Township 9 Range 18-WWell No. 1 ZimmermanCompany H. V. Elwell & Wenzel

1938

3/9

Simp. 3720'.

Arb. 3740'.

T.D. 3760'.

Cored 3745-60', Recovered 3'
good porosity & sat. W/water.

ABANDONED

2042

Rooks

KANSAS

Map No. 64 Sec. 15 Twp. 9 R. 18WWell No. 1 ZimmermanH V Elwell & Wenzel Company

Contractor

FIRST REPORT

NE NW

330 Ft. from N. Line Ft. from S. Line330 Ft. from E. Line Ft. from W. Line*Wildcat Test*

SECTION PLAT

Location XRig up

Drilling and Remarks:

RECORD

Cased in., ft.Sand Gas Oil Total Depth

PRODUCTION

1st 24 hrs. Nat. 1st 24 hrs. after shot Gas Cu. Ft.Dry Hole Abandoned

Date

DEC 8 - 1937

19

H. D. Hatfield

Scout

Map No. 64 Sec. 15 Twp. 9 R. 18WWell No. 1 ZimmermanH.V. Elwell & Wenzel Company

Contractor

ABANDONED

SECTION PLAT

		0	

NE NW

330 Ft. from N. Line

Ft. from S. Line

330 Ft. from E. Line

Ft. from W. Line

Location _____

Rig up _____

Drilling and Remarks:

Cored 3745-60
 Rec 3' good
 porosity & sat.
 w/water

D & A

RECORD

Cased _____ in., _____ ft.

Sand Simp 3720
ARB, 3740

Gas _____

Oil _____

Total Depth 3760

PRODUCTION

1st 24 hrs. Nat. _____

1st 24 hrs. after shot _____

Gas _____ Cu. Ft.

Dry Hole _____

Abandoned _____

Date

MAR 9 - 1938

19

H. D. Hatfield Scout