


Section 15 Township 9 Range 19 W

Well No. # 2 Casey

Company Westgate-Greenland

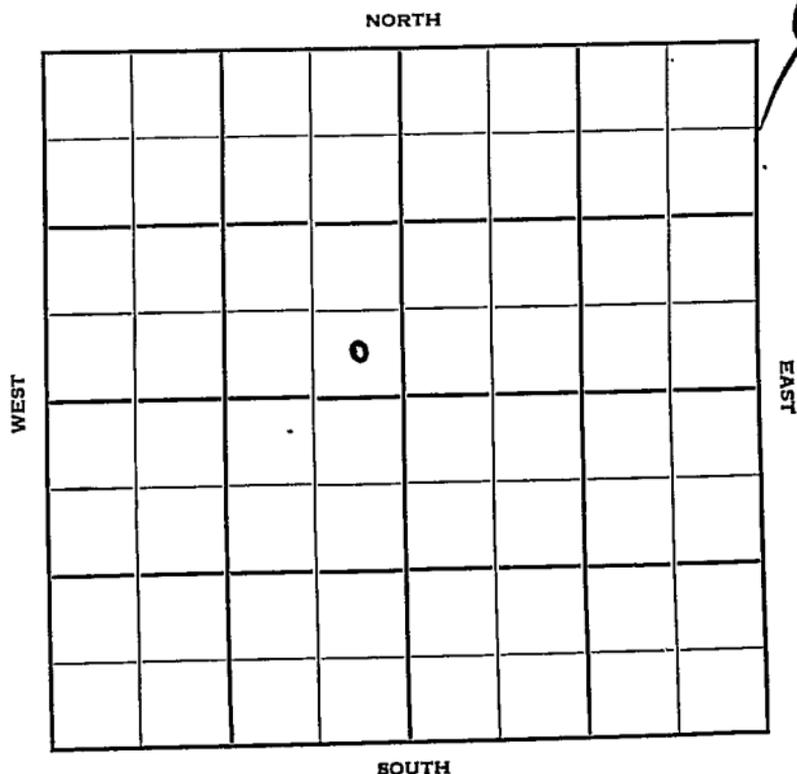

Sec. 15 Twp. 9 R. 19W

Well No. #2 Casey Farm

Westgate-Greenland Company

B & R Drlg. - Contr. Contractor


Chandler Pool

Ft. from N. Line

330' Ft. from S. Line

330' Ft. from E. Line

Ft. from W. Line

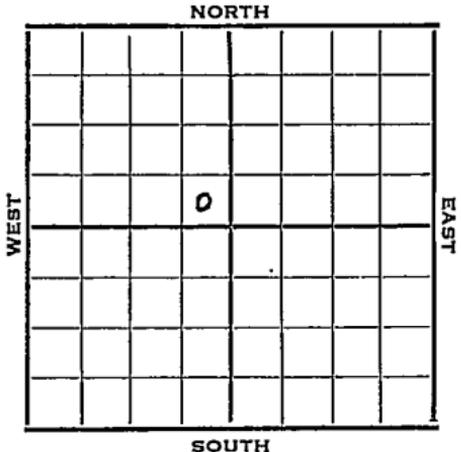

SE SE NW

1952

Elev. 2078' REPORT

- 5/14 Location
- 5/21 8" @ 209  
Anhy 1456  
Drlg. 1600'
- 5/28 Heeb 3223' Tor 3243' Lans. 3264'  
DST 3229-51, 1/2 hr, 15' M Off  
Drlg. 3280'
- 6/11 Spud 5-17-52  
D & A TD 3511' 8" @ 209  
Anhy 1456' Heeb 3223' Tor. 3243'  
Lans. 3264'  
DST 3229-51 open 1/2 hr. rec 15' mud  
DST 3281-3309 open 1 hr. rec 260' SW  
Arb. 3504' ED 3507' 7" @ 3504'  
DD 3511' 500 A B/23 GW 1 GOPH  
B/42 GF 1500 A 12/3505-07 PB 3484  
11/3463-68 S/5 GO 65 GW 2 1/2 hr.  
12/3436-46 11/3398-3406 S/2 GO  
40 GWPH D & A

**ABANDONED**



