

Section 15 Township 9 Range 19W

Well No. #2 Nech

Company Phillips Pet.

*9*

NORTH

							0

WEST

EAST

SOUTH

Rao

Rooks

KANSAS

Sec. 15 Twp. 9 R. 19 W

Well No. #2 Nech Farm

Phillips Pet. Company


Phillips Pet Contractor

330' Chandler Pool  
Ft. from N. Line

\_\_\_\_\_ Ft. from S. Line

330' Ft. from E. Line

\_\_\_\_\_ Ft. from W. Line

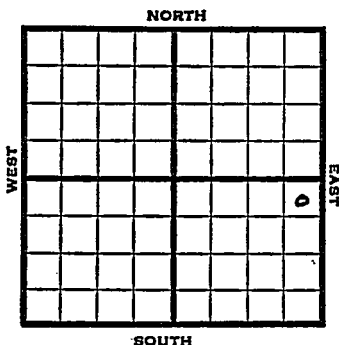

NE NE SE

1951 Elev. 2069' REPORT

2/7

Location

3/28

Spud 2-9-51

Oil well TD 3511'

Anhy 1442', 8-5/8" @ 1483',

Howard 3016', Top. 3040', Heeb. 3220'

Toronto 3238', Lans. 3258', Arb. 3503'

TD 3505', 5" @ 3504', DD 3511',

B/ 10 goph 500 A

Comp. 80 bopd 453 bw

**COMPLETED**



