

Section 15

Township 9

KANSAS
Range 19W

Well No. #1 Casey

Company Mid-Plains & Westgate-Greeland

12

NORTH

0							

WEST

EAST

SOUTH

Sec. 15 Twp. 9 R. 19W

Well No. #1 Casey Farm

Mid-Plains & Westgate-Greenland Company

B&R Drlg. Contractor

Berry Pool


NORTH

330 Ft. from N. Line

_____ Ft. from S. Line

_____ Ft. from E. Line

330 Ft. from W. Line

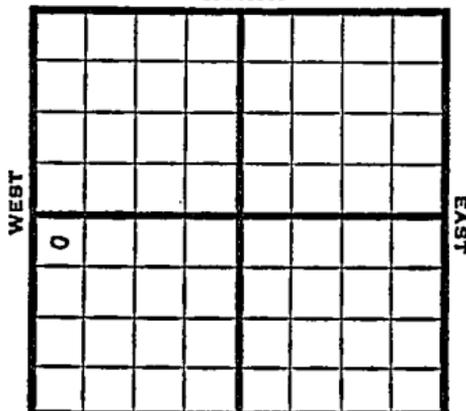

SOUTH

NW NW SW

1951 Elev. 2072' REPORT

11/21 1952 1/30 RUR

Spud 11-20-51
 Oil well TD 3535
 8" @ 186
 Anhy 1435 Heeb. 3227
 Tor. 3244
 DST 3237-54 open 1 hr. rec. 150' OCM
 240' oil 60' wtr.
 Lans. 3266 Cong. 3484
 Arb. 3507
 5" @ 3508 TD 3535 Arb. 3507
 5" @ 3508 TD 3535 1000 A
 wtr. PB 3292 24/ 3232-40
 24/ 3240-48 12/ 3248-52 B/ 55 GF
 1/2 hr. 75% wtr. S/ 2 BO 2 GWPH
 500 A S/ 3 BOPH
 Comp. 41 BOPD 28% wtr.

COMPLETED


County **Rooks** State **Kansas**

Sec. **15** (Blk. Twp.) **9** (Sur. Rge.) **19W** Map No.

Operator **Mid-Plains & Westgate-Greenland**

Well No. **1** Farm **Casey**

Elev. Location **NW NW SW**

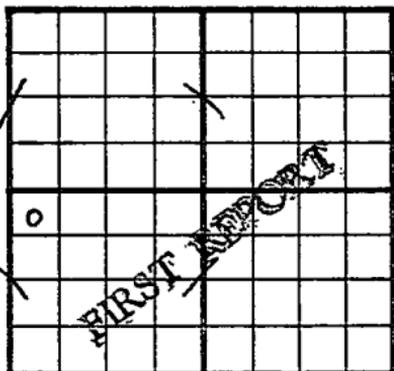

330 Ft. From **N** Line **SW**

330 Ft. From **W** Line Quarter

Ist. Report **NOV 21 1951**

Completion


Remarks **Derby DHM**

B & R Drlg. - Contr.

Spudding Date

Drlg. Data **Berry Pool**

R U R

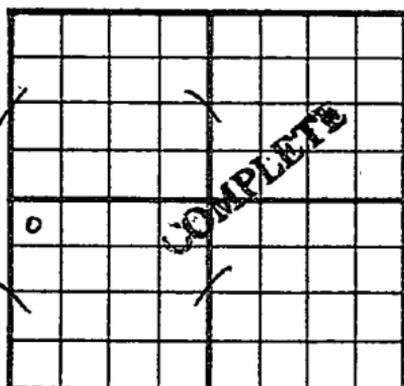County _____ Rooks _____ State KansasSec. 15 (Blk. 9) (Sur. 19W) (Twp.) _____ (Rge.) _____ Map No. _____Operator Mid-Plains & Westgate-GreenlandWell No. 1 Farm CaseyElev. 2072 Location NW NW SW330 Ft. From N Line SW330 Ft. From W Line Quarter

1st. Report _____

Completion JAN 3 0 1952Remarks W. Chandler PoolB & R Drlg. - Contr.Spudding Date 11-20-51Drlg. Data Oil well TD 35358" @ 186 Anhy 1435 Heeb. 3227Tor. 3244 DST 3237-54 open 1 hr.Rec. 150' ocm 240' oil 60' waterLans. 3266 Cong. 3484 Arb. 35075" @ 3508 TD 3535 1000 A waterPB 3292 24/ 3232-40 24/ 3240-4812/ 3248-52 B/ 55 g/f $\frac{1}{2}$ hr. 75% waterS/ 2 bo 2 gwph 500 A S/ 3 bophComp. 41 bopd 28% water

J. G. McGEHEE