



Section 15 Township 9 Range 19-W

Well No. #1 Nech

Company Phillips Pet

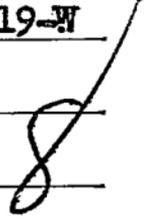

NORTH

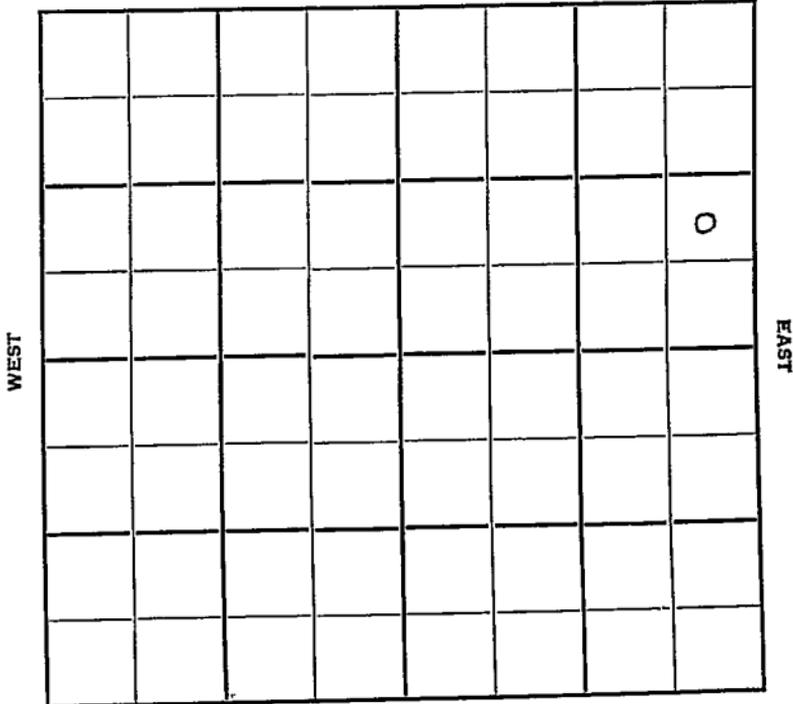

WEST

EAST

SOUTH

Sec. 15 Twp. 9 R. 19-W

Well No. #1 Nech Farm

Phillips Pet. Company

Phillips Pet Contractor

Chandler


_____ Ft. from N. Line

990 Ft. from S. Line

330 Ft. from E. Line

_____ Ft. from W. Line

NE SE NE

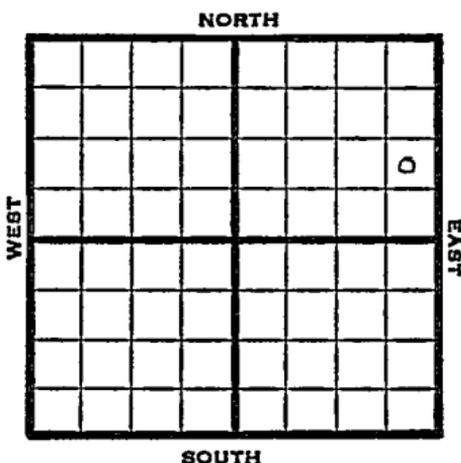

1950

Elev 2070

REPORT

8/2 Spud 7-30-50
Anhy 1445
running 8"

10/4 Anhy 1445
8" @ 1487

Howard 3011

Top 3033

Heeb 3212

Lans 3251

Arb 3493

TD 3495

5" @ 3494 DD to 3498

FU 500' oil 1 hr

DD 3500

FU 2100' oil

2 hr S/59 bo 2 hr

DD 3502

S/41 boph P/13 boph P/128 bo 6 hr

Comp 536 bopd 8% water

Completed

COMPLETED


Kansas

Chandler Pool

Map No. _____ Sec. 15 Twp. 9 R. 19WWell No. 1 Nech_____
Phillips Pet. _____ Company_____
Contractor

NE SE NE

SECTION PLAT

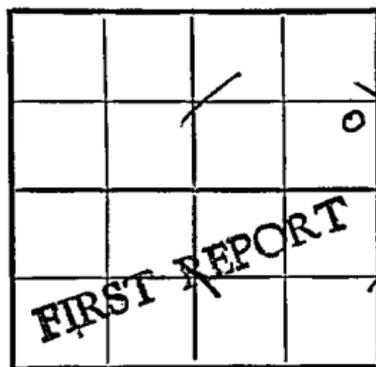

_____ Ft. from N. Line

990 Ft. from S. Line330 Ft. from E. Line

_____ Ft. from W. Line

Rooks County

Location _____

Rig up _____

Drilling and Remarks:

Spud 7-30-50

Anhy 1445

running 8"

RECORD

Cased _____ in., _____ ft.

Sand _____

Gas _____

Oil _____

Total Depth _____

PRODUCTION

1st 24 hrs. Nat. _____

1st 24 hrs. after shot _____

Gas _____ Cu. Ft.

Dry Hole _____

Abandoned _____

Date

AUG 2 1950 19J. E. TYRA Scout


County Rooks State Kansas

Sec. 15 (Blk. Twp.) 9 (Sur. Rge.) 19W Map No.

Operator Phillips Petroleum

Well No. 1 Farm Nech

Elev. 2070 Location NE SE NE

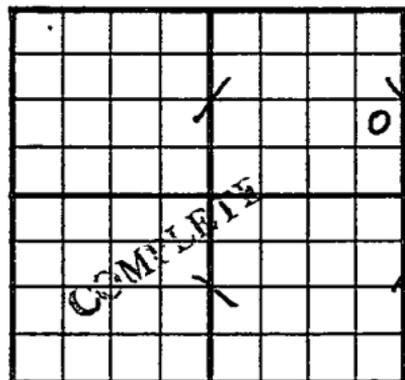

990 Ft. From S Line NE

330 Ft. From E Line Quarter

Ist. Report

Completion OCT 4 1950

Remarks Chandler Pool

Phillips Pet. - Contr.

Spudding Date 7-30-50

Drilg. Data Oil well TD 3502

Anhy 1445 8" @ 1487 Howard 3011

Top. 3033 Heeb. 3212 Lans. 3251

Arb. 3493 TD 3495 5" @ 3494 DD to 3498

FU 500' oil 1 hr. DD 3500 FU 2100' oil

2 hr. S/ 59 bo 2 hr. DD 3502

S/ 41 boph P/ 13 boph P/ 128 bo 6 hr.

Comp. 536 bopd 8% water

J. E. TYRA