


Section 15 Township 9 Range 19 W

Well No. # 6 Nech

Company Phillips Pet.

7

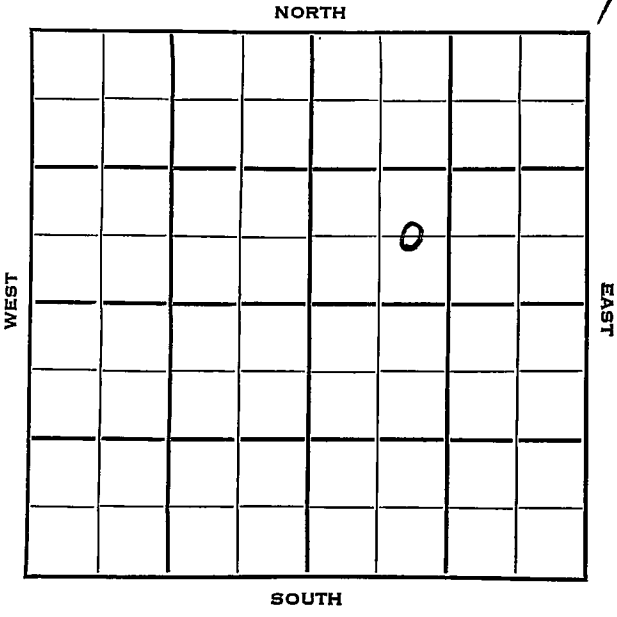

Rooks

KANSAS

SEC.	TWP.	R.
15	9	19 W

WELL NO.

6 Nech

FARM

COMPANY

Phillips Pet.

CONTRACTOR

Trans-Era

Jelinek Pool


1980 Ft. from N. Line

Ft. from S. Line

1650 Ft. from E. Line

Ft. from W. Line

C E L SW NE

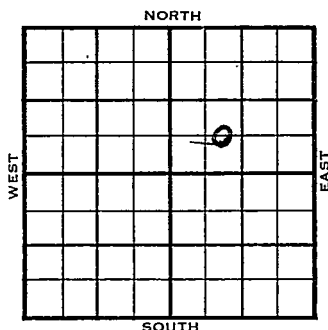

1953

ELEVATION

2075'

REPORT

11/24

MIR

12/9

10" @ 221 Howard 3012 Top 3039
 Heeb 3218 Tor. 3237' Lans 3258
 B KC 3477 Arb. 3496
 RTD 3498 Schl 7" @ 3497

12/16

CO 3498', NS
 DD 3506',
 S/57 bo 1 $\frac{1}{4}$ hrs.,
 S/22 bo 2 hrs.
 DD 3508
 FU 1400' oil 2 hrs.
 S/49 $\frac{1}{2}$ bo + 8 $\frac{1}{2}$ bw 3 hrs.
 S/17 bo + 3 bw 1 hr.

1954

1/13

Comm 11-26-53
 Oil Well
 TD 3508'
 10-3/4" @ 221'
 Howard 3012', Top 3039', Heeb 3218',
 Tor 3237', Lans 3258', B KC 3477',
 Arb 3496'
 TD 3498'
 7" @ 3497'
 CO to 3498 DD 3506
 S/ 57 bo 1 $\frac{1}{4}$ hr. S/ 22 bo 2 hr.

1954

Information brought forward.

1/13

DD 3508'

FU 1400' oil 2 hr.

S/ 49 $\frac{1}{2}$ bo 8 $\frac{1}{2}$ bw 3 hr.

S/ 17 bo 3 bw 1 hr.

Comp 316 bopd 79bw.

COMPLETED

