FORM 51

Rooks KANSAS

Section 15 Township 9 Range 19 W

Well No. # 7 Nech

Company Phillips Pet.

9

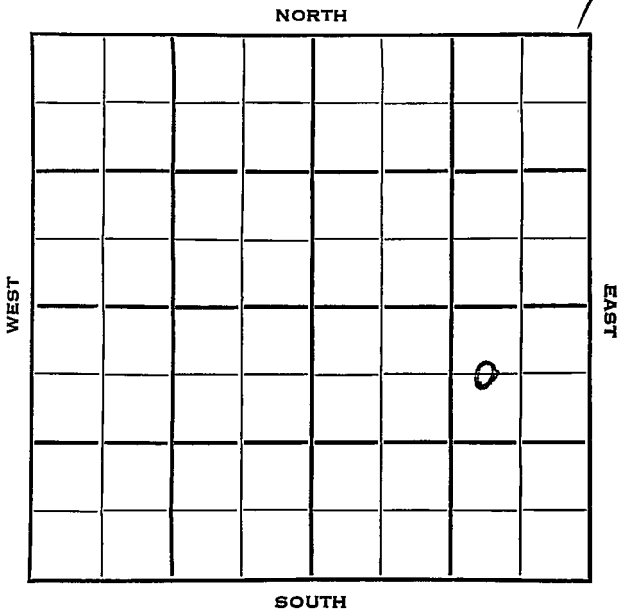

Rooks KANSAS

| SEC. | TWP. | R. |
|---|---|---|
| 15 | 9 | 19 W |

WELL NO.
# 7 Nech FARM

COMPANY
Phillips Pet.

CONTRACTOR
Ferrell Drlg.

Jelineck Pool

_____ Ft. from N. Line

1980 Ft. from S. Line

990 Ft. from E. Line

_____ Ft. from W. Line

C W L NE SE

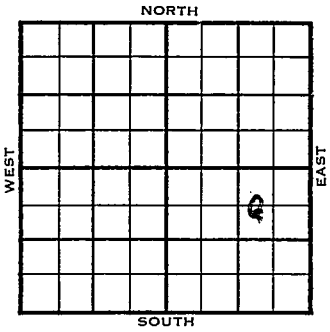


| 1953 | ELEVATION 2083' REPORT |
|---|---|
| 11/24 | Location |
| 12/9 | 10" @ 220<br>Drlg. 1590' |
| 12/16 | Howard 3023', Top 3048', Heeb 3227',<br>Tor 3248', Lans 3268'<br>Drlg. 3415' |
| 1954<br>1/13 | Spud 12-4-53<br>Oil Well<br>TD 3516'<br>10" @ 220'<br>Howard 3023', Top 3048', Heeb 3227'<br>Tor 3248', Lans 3268', B KC 3486',<br>Arb 3509'<br>TD 3511'<br>7" @ 3509'<br>CO to 3511'<br>6 goph DD 3512' FU 700' oil 1 hr.<br>DD 3516'<br>S/ 102 bo 2 hr.<br>S/ 229 bo 1% bsw 11 hr.<br>S/ 19 bo 1 hr.<br>Comp 541 bopd 14 bw. |

COMPLETED

DX-78

FORM 275 FOR SALE BY KANSAS BLUE PRINT CO.

County Rooks State Kansas

Sec. 15 (Blk. Twp.) 9 (Sur. Rge.) 19W Map No.

Operator Phillips Pet.

Well No. 7 Farm Nech

Elev. Location C W L NE SE

| | | | | | | | |
|---|---|---|---|---|---|---|---|
| | | | | | | | |
| | | | | | | | |
| | | | | | | | |
| | | | | | | | |
| | | | | | | | |
| | | | | | | | |
| | | | | | | | |

FIRST REPORT

1980 Ft. From S Line SE

990 Ft. From E Line Quarter

1st. Report NOV 24 1953

Completion

Remarks

Ferrell Drlg. - Contr.

Spudding Date

Drlg. Data Jelinek Pool

Location

J. G. McGEHEE

FORM 275 FOR SALE BY KANSAS BLUE PRINT CO.

County Rooks State Kansas

Sec. 15 (Blk. / Twp.) 9 (Sur. / Rge.) 19W Map No.

Operator Phillips Pet.

Well No. 7 Farm Nech

Elev. 2083 Location C W L NE SE

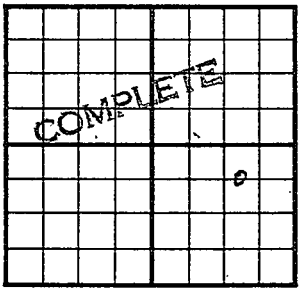


1980 Ft. From S Line SE

990 Ft. From E Line Quarter

1st. Report

Completion JAN 13 1954

Remarks Jelinek Pool

Ferrell Drlg. - Contr.

Spudding Date 12-4-53

Drlg. Data Oil well TD 3516

10" @ 220 Howard 3023 Top. 3048

Heeb. 3227 Tor. 3248 Lans. 3268

B KC 3486 Arb. 3509 TD 3511 7" @ 3509

CO to 3511 6 goph DD 3512 FU 700# oil

1 hr. DD 3516 S/ 102 bo 2 hr.

S/ 229 bo 1% bsw 11 hr. S/ 19 bo 1 hr.

Comp. 541 bopd 14 bw

J. G. McGEHEE