

KANSAS

Rooks

Section 15 Township 9 Range 20W

Well No. 1 Kern

Company Birmingham & Bartlett

Wildcat

NORTH

				0			

WEST

EAST

SOUTH

2

Sec. 15 Twp. 9 R. 20W

Well No. #1 Kern Farm

Birmingham & Bartlett Company

Wildcat (Birmingham & Bartlett, Cont.)


330' Ft. from N. Line

_____ Ft. from S. Line

_____ Ft. from E. Line

330' Ft. from W. Line

NW NE

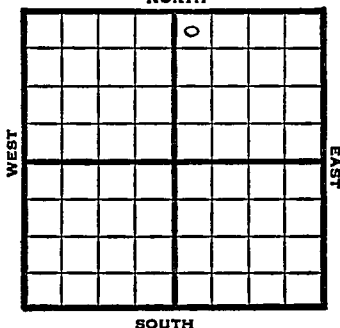

1949 ELEV 2153' REPORT

10/19 Location
10/26 "
11/1 10" @ 191'
Drlg. 3195'
11/9 Lansing 3397'
Arbuckle 3666'
TD 3673'
5" @ 3667'
11/16 TD 3706'
Arb. 3666'
Aband.

ABANDONED

Map No. _____ Sec. 15 Twp. 9 R. 20W

Well No. 1 Kern

Birmingham & Bartlett Company

Birmingham & Bartlett Contractor

NW NE

FIRST REPORT
SECTION PLAT

330 Ft. from N. Line

_____ Ft. from S. Line

_____ Ft. from E. Line

330 Ft. from W. Line

		o	

Rooks County

Location X

Rig up _____

Drilling and Remarks:

RECORD

Cased _____ in., _____ ft.

Sand _____

Gas _____

Oil _____

Total Depth _____

PRODUCTION

1st 24 hrs. Nat. _____

1st 24 hrs. after shot _____

Gas _____ Cu. Ft.

Dry Hole _____

Abandoned _____

Date

OCT 19 1949

19

S. J. LEWIS Scout

Kansas

Map No. _____ Sec. 15 Twp. 9 R. 20W

Well No. 1 Kern

Birmingham & Bartlett Company

ABANDONED

Contractor

NW NE

E. 2153
SECTION PLAT

330 Ft. from N. Line

Ft. from S. Line

Ft. from E. Line

330 Ft. from W. Line

		5	

Rooks County

Location _____

Rig up _____

Drilling and Remarks:

Per 3666

RECORD

Cased _____ in., _____ ft.

Sand _____

Gas _____

Oil _____

Total Depth *3216*

PRODUCTION

1st 24 hrs. Nat. _____

1st 24 hrs. after shot _____

Gas _____ Cu. Ft.

Dry Hole _____

Abandoned _____

Date

NOV 16 1949 19

S. J. LEWIS Scout