



Rooks

KANSAS

Sec. 15 Twp. 9 R. 20W ✓

Well No. #1 Gish Farm

Barnett Oil Company

Hartmann - Contr. Contractor

Wildcat


330' Ft. from N. Line

\_\_\_\_\_ Ft. from S. Line

\_\_\_\_\_ Ft. from E. Line

330' Ft. from W. Line

NW NW SE

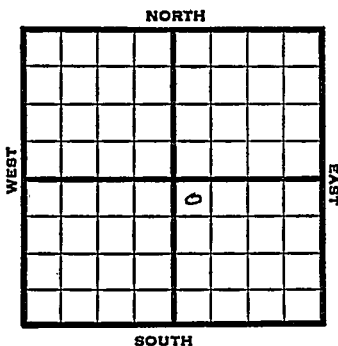

1951 Elev. 2168' REPORT

3/28  
4/18

RUR

Spud 3-31-51

D & A TD 3830'

8" @ 164 Top. 3178 Heeb 3385'

Lans. 3424'

DST 3461-80 open 1 hr. rec 30' mud

DST 3606-38' open 1 hr. rec 10' mud

Cong 3711', ReArb. 3725', Arb. 3796'

TD 3830' D & A

**ABANDONED**


County Rooks State Kansas

Sec. 15 (Blk. 9 (Sur. Rge.) 20W Map No.

Operator Barnett Oil

Well No. 1 Farm Gish

Elev. \_\_\_\_\_ Location NW NW SE

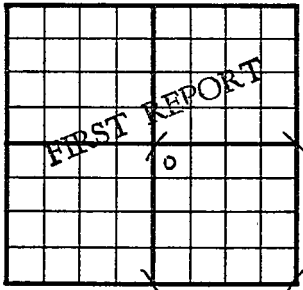

330 Ft. From N Line SE

330 Ft. From W Line Quarter

Ist. Report MAR 28 1951

Completion \_\_\_\_\_

Remarks \_\_\_\_\_

Hartman - Contr.

Spudding Date \_\_\_\_\_

Drilg. Data Wildcat

R U R

J. E. TYRA

County \_\_\_\_\_ Rooks \_\_\_\_\_ State Kansas

Sec. 15 (Blk. Twp.) 9 (Sur. Rge.) 20W Map No. \_\_\_\_\_

Operator Barnett Oil

Well No. 1 Farm Gish

Elev. 2168 Location NW NW SE


**ABANDONED**

0

330 Ft. From N Line SE

330 Ft. From W Line Quarter

1st. Report

Completion APR 18 1951

Remarks Wildcat

Peel - Hardman - Contr.

Spudding Date 3-31-51

Drlg. Data D & A TD 3830

8" @ 164 Top. 3178 Heeb. 3385

Lans. 3424 DST 3461-80 open 1 hr.

Rec. 30' mud DST 3606-38 open 1 hr.

Rec. 10' mud Cong. 3711 ReArb. 3725

Arb. 3796 TD 3830

D & A