

KANSAS


Graham

FORM 51 5M 10-41 PETROL

Section 15 Township 9 Range 21-W

Well No. #2 Morel

Company Continental etal.

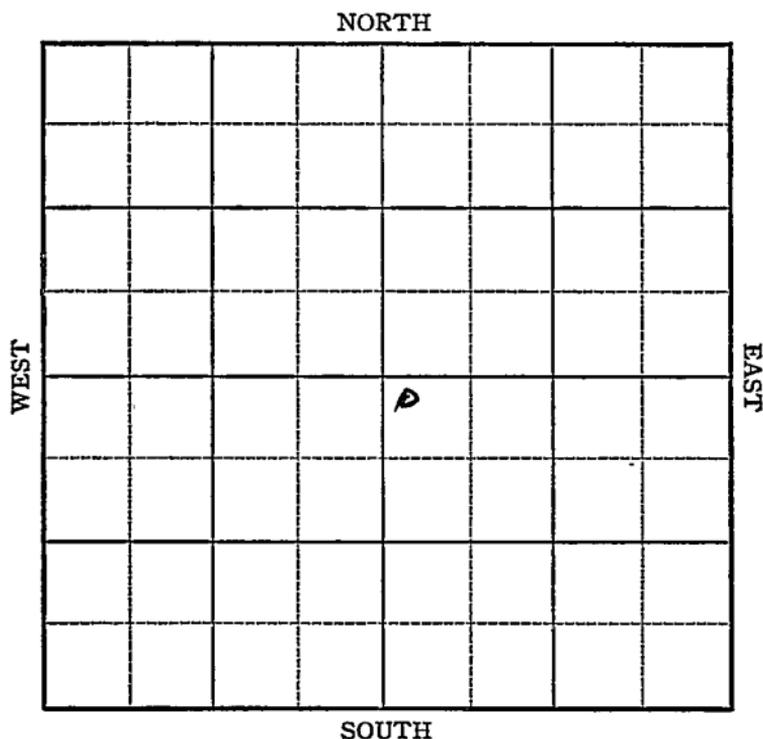

Sec. 15 Twp. 9 R. 21-W

Well No. #2 Morel Farm

Continental etal.

Company


Morel Pool

330 Ft. from N. Line

_____ Ft. from S. Line

_____ Ft. from E. Line

330 Ft. from W. Line

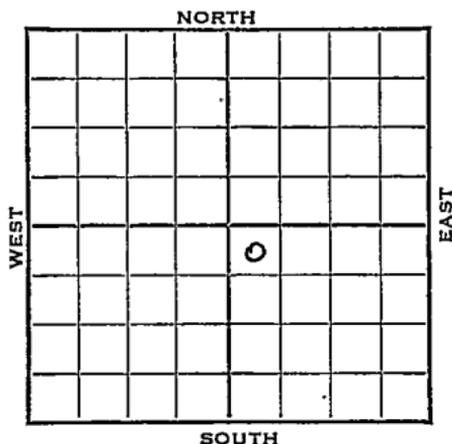

NW SE Elev. 2216

1942

REPORT

-12/22

Loc.

12/29

Rigging up rotary

1943

1/6

10" Casing set at 241'

Drlg. 2805'

1/13

Arb. 3679

7" casing set 3689'

TD 3708' RUST

1/20

2800' oil $\frac{1}{2}$ hr.

1/27

Swab 200 oil in 4 hrs.

2/3

Arb. 3679

7" casing set 3689'

T.D. 3708'

Echo Pot. 3000

Gravity 29.3

COMPLETED

KANSAS

Graham

Map No. 65 Sec. 15 Twp. 9 R. 21WWell No. 2 Morel

Continental etal.

Company

FIRST REPORT

Contractor

NW SE

SECTION PLAT

330 Ft. from N. Line

_____ Ft. from S. Line

_____ Ft. from E. Line

330 Ft. from W. Line

		o	

MOREL POOL

Location XXX

Rig up _____

Drilling and Remarks:

RECORD

Cased _____ in., _____ ft.

Sand _____

Gas _____

Oil _____

Total Depth _____

PRODUCTION

1st 24 hrs. Nat. _____

1st 24 hrs. after shot _____

Gas _____ Cu. Ft.

Dry Hole _____

Abandoned _____

Date

DEC 22 1942 19

S I LEWIS Scout

KANSAS

Map No. 05 Sec. 15 Twp. 9 R. 21W

Well No. 2 Morel

Continental etal. Company

COMPLETED Contractor

NW SE

SECTION PLAT

330 Ft. from N. Line

_____ Ft. from S. Line

_____ Ft. from E. Line

330 Ft. from W. Line

MOREL POOL

Location _____

Rig up _____

Drilling and Remarks:

Per # 3679
9" @ 3689
Echd P # 3000

298 1/2

RECORD

Cased _____ in., _____ ft.

Sand _____

Gas _____

Oil _____

Total Depth 3208

PRODUCTION

1st 24 hrs. Nat. _____

1st 24 hrs. after shot _____

Gas _____ Cu. Ft.

Dry Hole _____

Abandoned _____

Date

FEB 3 1943 19

S. J. LEWIS Scout