


Graham  
KANSAS

Form 51--5M--11-38--Palace

Section 15 Township 9 Range 21-W

Well No. 1 Trexler

Company Continental et al

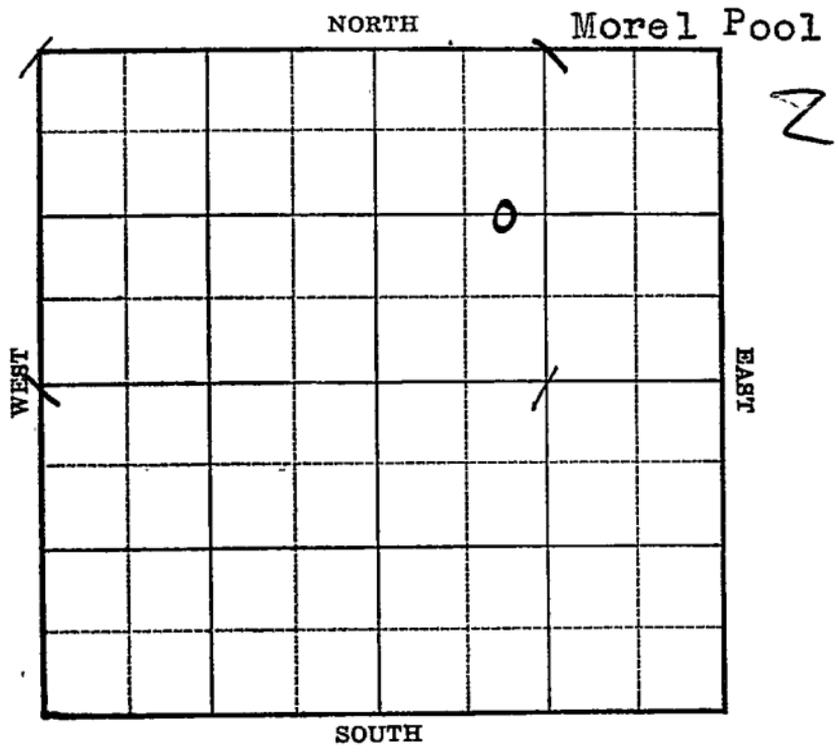

Sec. 15 Twp. 9 R. 21-W

Well No. #1 Trexler Farm

Continental et al Company


(Morel)

1320 Ft. from N. Line

\_\_\_\_\_ Ft. from S. Line

\_\_\_\_\_ Ft. from E. Line

990 Ft. from W. Line

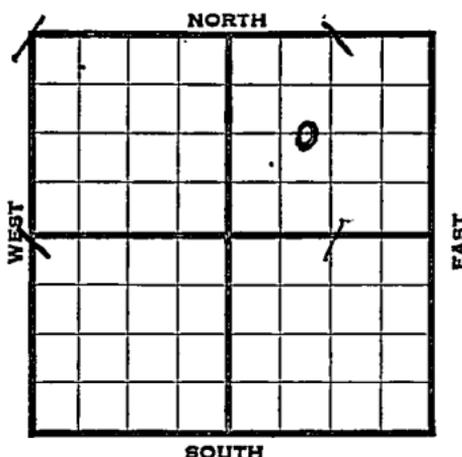

Elev. 2230'

1939	REPORT
3/8	Location
3/17	R.U.R.
3/24	13" - 246' Drlg. 1024'
3/31	9" - 1531' Drlg. 2530'
4/7	Drlg. 3665'
4/14	Arb. 3689-99' T.D. S. O. 7" - 3691' RUST.
4/21	Drilled plug. 3000' oil 6 hrs. Drlg. 3717' No Inc.
4/28	" " " "
5/5	T.D. 3721' Pump 758 bbls. in 8 hrs. Potential 2271 bbls. nat
5/10	Arb. 3689' 7" - 3691' T. D. 3721' * Pump 758 bbls. in 8 hours. Potential 2271 bbls., Nat'l.
	<b>COMPLETED</b>

Graham

Map No. 65 Sec. 15 Twp. 9 R. 21WWell No. 1 TrexlerContinental etal Company

Contractor

## FIRST REPORT


C E L W  $\frac{1}{2}$  NE1320 Ft. from N. Line

\_\_\_\_\_ Ft. from S. Line

\_\_\_\_\_ Ft. from E. Line

990 Ft. from W. Line

## SECTION PLAT

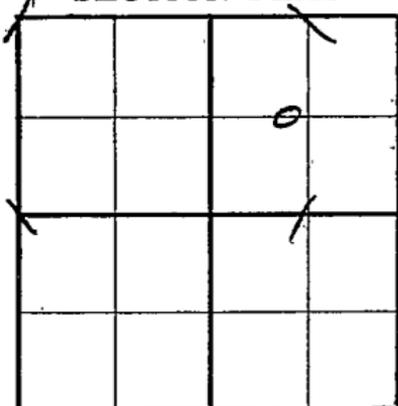

## MOREL POOL

Location X

Rig up \_\_\_\_\_

Drilling and Remarks:

## RECORD

Cased \_\_\_\_\_ in., \_\_\_\_\_ ft.

Sand \_\_\_\_\_

Gas \_\_\_\_\_

Oil \_\_\_\_\_

Total Depth \_\_\_\_\_

## PRODUCTION

1st 24 hrs. Nat. \_\_\_\_\_

1st 24 hrs. after shot \_\_\_\_\_

Gas \_\_\_\_\_ Cu. Ft.

Dry Hole \_\_\_\_\_

Abandoned \_\_\_\_\_

Date

MAR 8 - 1939 19H. D. Hatfield Scout

Map No. 65 Sec. 15 Twp. 9 R. 21W

Well No. 1 Trexler

Continental etal Company

Contractor

**COMPLETED**

**SECTION PLAT**

**C E L W $\frac{1}{2}$  NE**  
1320 Ft. from N. Line

\_\_\_\_\_ Ft. from S. Line

\_\_\_\_\_ Ft. from E. Line

990 Ft. from W. Line

		0	

**MOREL POOL**

Location \_\_\_\_\_

Rig up \_\_\_\_\_

Drilling and Remarks:

*Ce 8.3689*  
*7" @ 3691*  
*Pump 758 in 8 hrs*  
*P. 2271 Nat.*

**RECORD**

Cased \_\_\_\_\_ in., \_\_\_\_\_ ft.

Sand \_\_\_\_\_

Gas \_\_\_\_\_

Oil \_\_\_\_\_

Total Depth 3721

**PRODUCTION**

1st 24 hrs. Nat. \_\_\_\_\_

1st 24 hrs. after shot \_\_\_\_\_

Gas \_\_\_\_\_ Cu. Ft.

Dry Hole \_\_\_\_\_

Abandoned \_\_\_\_\_

Date

MAY 10 1939

S. J. LEWIS Scout