


Graham

Section 15 Township 9 Range 21W

Well No. #5 Trexler

Company Continental etal.

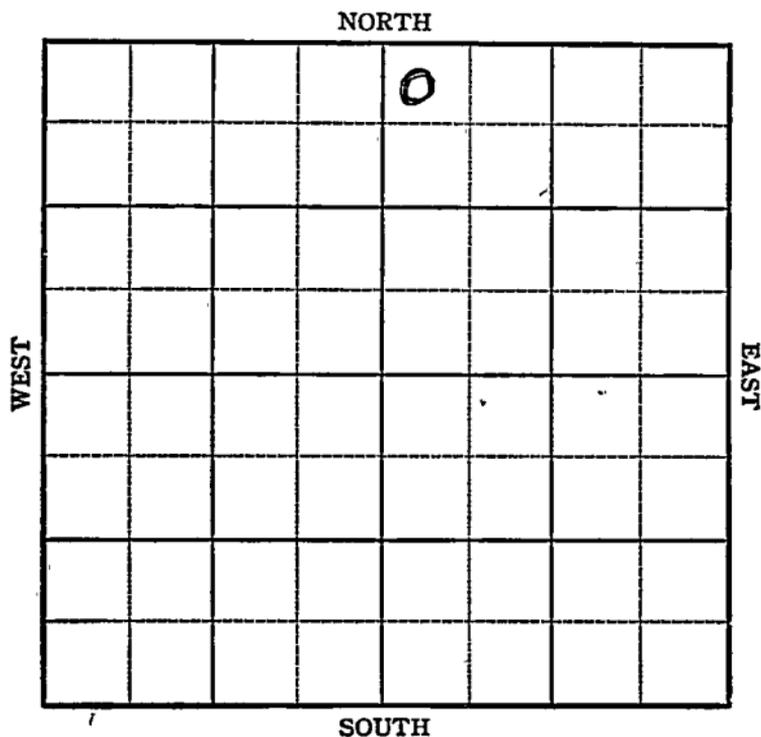

KANSAS

Graham

Sec. 15 Twp. 9 R. 21-W


Well No. #5 Trexler Farm
Continental etal Company

330 Ft. from N. Line

_____ Ft. from S. Line

_____ Ft. from E. Line

330 Ft. from W. Line

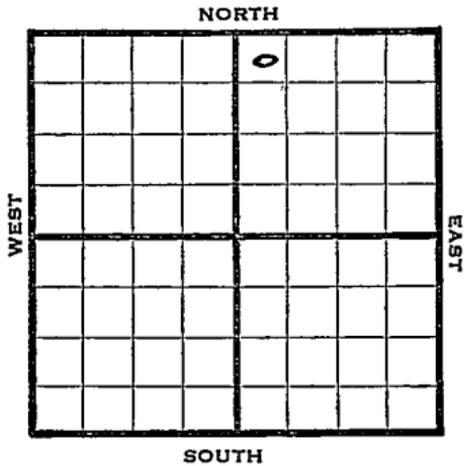

Morel Wes. 22/8

REPORT

1944

3/15	Location.
3/22	"
3/29	"
4/5	Derrick
4/12	10" @ 240 Drlg. 1480
4/19	Drlg. 3080
4/26	3415 fsg.
5/3	Drlg. 3680
5-10	Arb 3669 TD 3678 6" @ 3672 RUST
5/17	T.D. 3689 - 2300' oil
5/24	TD 3698 Run Liner
5/31	No Arb. Sand 3685 60' of 4 1/2" liner at 3698 Perforated shot 8 oil per hr 8 hrs.

OVER

1944

6/7 6" @ 3672
Arb. 3669
Sand 3685
TD 3698
60' of 4" Perf Liner 3698
500 acid
Pump 428 Pot
Grav. 30.2

COMPLETED

KANSAS

Map No. 65 Sec. 15 Twp. 9 R. 21WWell No. 5 TrexlerContinental et al. Company

FIRST REPORT Contractor

NW NE

SECTION PLAT

330 Ft. from N. Line

		o	

_____ Ft. from S. Line

_____ Ft. from E. Line

330 Ft. from W. Line

Morel Pool

Location X

Rig up _____

Drilling and Remarks:

RECORD

Cased _____ in., _____ ft.

Sand _____

Gas _____

Oil _____

Total Depth _____

PRODUCTION

1st 24 hrs. Nat. _____

1st 24 hrs. after shot _____

Gas _____ Cu. Ft.

Dry Hole _____

Abandoned _____

Date

MAR 15 1944 19 S. J. LEWIS Scout

KANSAS

Pool Name Morel

Map No. 45 Sec. 15 Twp. 9 R. 21W

Well No. 5 Trexler

Continental etal. Company

COMPLETED Contractor

NW NE

SECTION FLAT

330 Ft. from N. Line

_____ Ft. from S. Line

_____ Ft. from E. Line

330 Ft. from W. Line

		0	

Graham County

Location _____

Rig up _____

Drilling and Remarks:

Cer 83669
6" @ 3672
Card 3685
60' of 4" Perf Liner 3698
500 acid
Pump #25 RT
(30) 2 1/2

RECORD

Cased _____ in., _____ ft.

Sand _____

Gas _____

Oil _____

Total Depth 3698

PRODUCTION

1st 24 hrs. Nat. _____

1st 24 hrs. after shot _____

Gas _____ Cu. Ft.

Dry Hole _____

Abandoned _____

Date

JUN 7 1944

19

S. J. LEWIS

Scout