


Section 15 Township 9 Range 21W

Well No. #4 Benson

Company Sohio

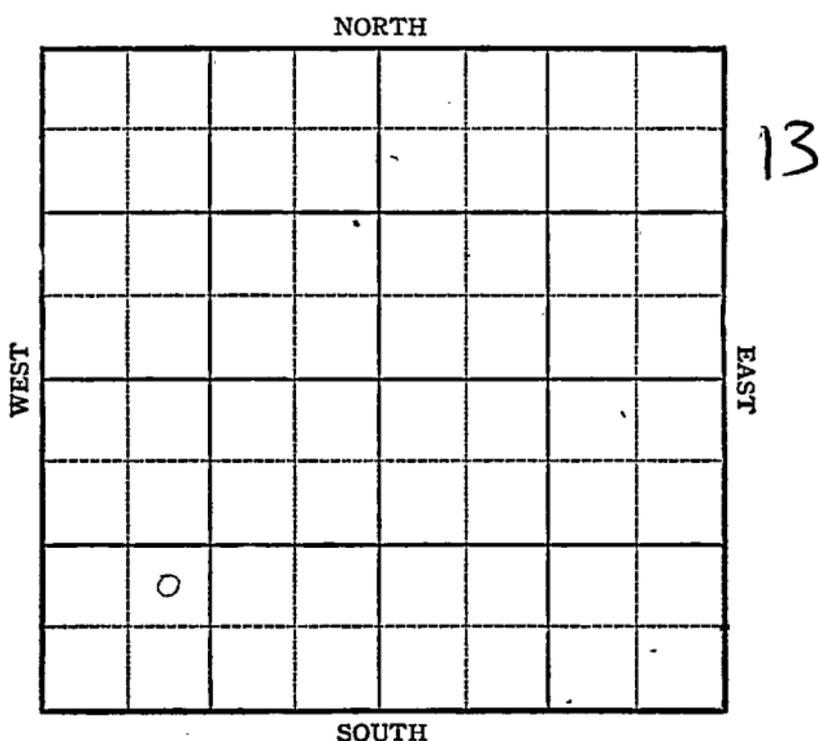

Sec. 15 Twp. 9 R. 21W

Well No. 4 Benson Farm

Sohio Company

NE SW SW


NORTH

_____ Ft. from N. Line

1080 Ft. from S. Line

_____ Ft. from E. Line

1270 Ft. from W. Line

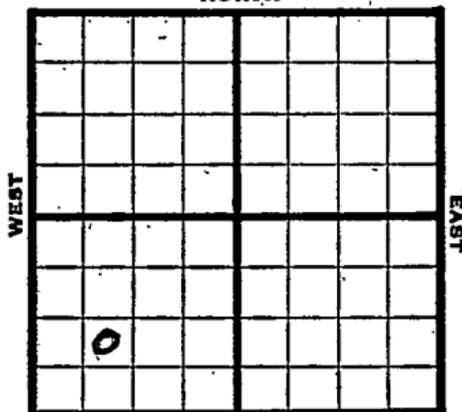

SOUTH

Elm. 2273

1944

REPORT

9-13	Location
9/21	"
9/28	Bldg. Drk.
10/4	10" @ 245 Drlg.
10/11	Drlg. 2595
10/18	Lans 3462
	Arb 3755 TD
	5" @ 3755 RUST
10/25	Arb 3753 corrected
	5" @ 3753
	TD 3758
	swb 40 oil per hr 9 hr.
11/2	" " " " " " " "
11/8	" " " " " " " "
11/16	" " " " " " " "
11/24	" " " " " " " "
11/29	" " " " " " " "
12/6	" " " " " " " "
12/14	" " " " " " " "
12/21	" " " " " " " "
12/27	Arb. 3753
	5" @ 3753
	TD 3758
	Depth Pot 3000
	Grav. 29.3

COMPLETED

KANSAS

Pool Name Morel

Map No. (6) Sec. 15 Twp. 9 R. 21 W

Well No. 4 Benson

Schie Company

FIRST REPORT

Contractor

NE SW SW

SECTION PLAT

_____ Ft. from N. Line

1080 Ft. from S. Line

_____ Ft. from E. Line

1270 Ft. from W. Line

Graham County

Location X

Rig up _____

Drilling and Remarks:

RECORD

Cased _____ in., _____ ft.

Sand _____

Gas _____

Oil _____

Total Depth _____

PRODUCTION

1st 24 hrs. Nat. _____

1st 24 hrs. after shot _____

Gas _____ Cu. Ft.

Dry Hole _____

Abandoned _____

Date

SEP 13 1944 19

S. J. LEWIS Scout

Pool Name MorelMap No. 65 Sec. 15 Twp. 9 R. 21WWell No. 4 BensonSohio

Company

COMPLETED

Contractor

NE SW SW

SECTION PLAT

 Ft. from N. Line1080 Ft. from S. Line Ft. from E. Line1270 Ft. from W. Line

e			

Graham CountyLocation Rig up

Drilling and Remarks:

Per 83753
5103753
Depth 3000

293/4

RECORD

Cased in., ft.Sand Gas Oil Total Depth 3758

PRODUCTION

1st 24 hrs. Nat. 1st 24 hrs. after shot Gas Cu. Ft.Dry Hole Abandoned

Date

DEC 27 1944

19

S. J. LEWIS

Scout