

Section 15 Township 9 Range 21W

Well No. 7 Benson

Company Sohio et al

Morel Pool
NORTH

14

WEST

EAST

SOUTH

0

Sec. 15 Twp. 9 R. 21W

Well No. #7 Benson Farm

Sohio et al Company

Morel Pool


_____ Ft. from N. Line

990' Ft. from S. Line

330' Ft. from E. Line

_____ Ft. from W. Line

NE SE SW

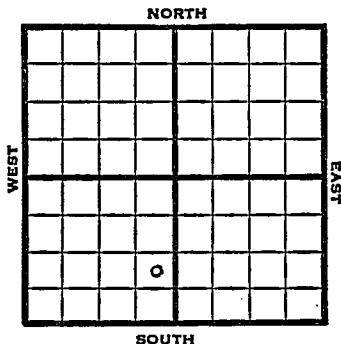

1948	Elev 2263'	REPORT
12/29		Surface Hole
1/5		8" @ 1713'
		Drlg. 2030'
1/12		Drlg 3680
1/19		Lansing 3442'
		Arb 3720'
		Reagan 4185'
		Granite Wash 4200'
		TD 4222'
		5" @ 3836'
1/26		PB 3758'
2/2		18 shots 3720-26
		Swb 40 bbls oil PH - 2 hrs.
2/9		"
2/16		"
2/23		"
3/2		"
3/8		"
3/16		"
3/23		TD 4222'
		Arb. 3720'
		Reagan 4185'
		Grante Wash 4200'
		5" @ 3836'
		Perfart 500 acid
		Echo Pot 3000
		30° Gr.
		Comp
COMPLETED		

Map No. _____ Sec. 15 Twp. 9 R. 21W

Well No. 7 Benson


Sohio etal. Company

FIRST REPORT

Contractor _____

NE SE SW

SECTION PLAT

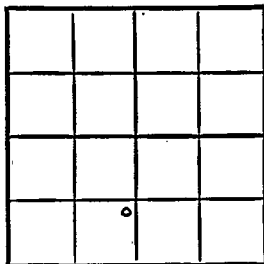

_____ Ft. from N. Line

990 Ft. from S. Line

330 Ft. from E. Line

_____ Ft. from W. Line

Graham County

Location _____

Rig up _____

Drilling and Remarks:

surface hole

RECORD

Cased _____ in., _____ ft.

Sand _____

Gas _____

Oil _____

Total Depth _____

PRODUCTION

1st 24 hrs. Nat. _____

1st 24 hrs. after shot _____

Gas _____ Cu. Ft.

Dry Hole _____

Abandoned _____

Date

DEC 29 1948

19

S. J. LEWIS

Scout

Kansas

Map No. 65 Sec. 15 Twp. 9 R. 21WWell No. 7 Benson

Sohio etal.

Company

COMPLETE

Contractor

NE SE SW

E/2263
SECTION PLAT

_____ Ft. from N. Line

990 Ft. from S. Line330 Ft. from E. Line

_____ Ft. from W. Line

Graham County

RECORD

Location _____

Cased _____ in., _____ ft.

Rig up _____

Sand _____

Drilling and Remarks:

Gas _____

Oil _____

Total Depth 4222.

PRODUCTION

1st 24 hrs. Nat. _____

1st 24 hrs. after shot _____

Gas _____ Cu. Ft.

Dry Hole _____

Abandoned _____

Co #3720
Ragan #175
Granite Mark 4200
5" 03536
Payor #.
5000000
Eckert #2 3000
30th St

Date

MAR 23 1949 19

S. J. LEWIS Scout