

Graham


KANSAS

Form 51-5M 5-37 Petrol

Section 15 Township 9 Range 21-W

Well No. 1 ~~Trexler~~ Morel

Company Continental and Cities Service

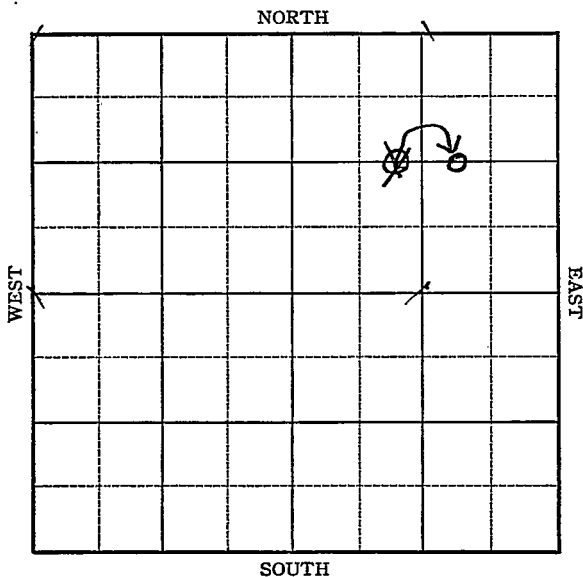

3/19--Show oil 3599-3603
 Cored 3603-10--recovered 2 feet
 Small show oil
 Top Conglomerate 3670 Dlg. 3685 (Tel)

3/21--Top Arbuckle 3712
 Cored 3714-19--recovered $1\frac{1}{2}$ feet fairly
 saturated core Saturation in cuttings
 T.D. 3719 Will run pipe (Tel)

3/25 S.O. 3451-55'.
 3456-57'.
 3493-96'.
 3496-3501'.
 3599-3610'.

Base K. C. 3628'.

Cong. 3600'.

Simp. sand. 3697'.

Arb. 3712'.

Cored 3714-19', Rec. $1\frac{1}{2}$ ' sat.

T.D. 3719'. 7" @ 3712'.

RUST.

3/28--Drilled plugs filled up 800 feet oil
 1st hour. Filled up 2700 feet
 oil in 12 hours Gravity 27.3
 Cleaning out may deepen (Tel)

3/29--Deepened 2 feet T.D. now 3721
 Hard lime No apparent increase in oil
 Shut down for tanks (Tel)

4/5--Swabbed 192 bbls. in 4 hours Swabbed
 down 700 feet off bottom Filled up
 1800 feet additional in 1 hour
 Will acidize Gravity 27 (Tel)

4/12--~~Acidized 1000 gallons~~ Swabbed 50 bbls.
 oil per hour for 15 hours At end of
 4th hour had 3000 feet oil in hole
 Didn't swab down
 Gravity 31 Corrected (Tel)

OVER

OVER

4/13--Arbuckle 3712 TD 3721 7" 3712
 Correction--this well has not been
 acidized
 1st hour pump 63 bbls.
 2nd " " 73 "
 3rd " " 79 "
 4th " " 81 "
 5th " " 82 "
 6th " " 94 " Natural (Tel)
 Gravity 31 Corrected

4/15--Potential 2105 bbls. natural
 Gravity 27 plus Corrected (Telegram)

4/20 7" @ 3712'.
 Arb. 3712'.
 T.D. 3721'.
 Potential 2105 bbls. natural.

COMPLETED

Graham

KANSAS

Map No. 65 Sec. 15 Twp. 9 R. 21WWell No. 1 Trexler

Continental and Cities Service Company


Contractor

FIRST REPORT

C EL W $\frac{1}{2}$ NE1320 Ft. from N. Line Ft. from S. Line Ft. from E. Line990 Ft. from W. Line

Special

SECTION PLAT

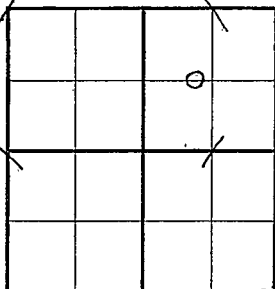Location XRig up

Drilling and Remarks:

RECORD

Cased in., ft.Sand Gas Oil Total Depth

PRODUCTION

1st 24 hrs. Nat. 1st 24 hrs. after shot Gas Cu. Ft.Dry Hole Abandoned

Date

JAN 5 - 1938

19

H. D. Hatfield

Scout

Graham
KANSASMap No. 65 Sec. 15 Twp. 9 R. 21 WWell No. 1-Morel

Cont. & Cities Service Company

Contractor

C W L E 2 NE
CORRECTION1320 Ft. from N. Line Ft. from S. Line990 Ft. from E. Line Ft. from W. Line

SECTION PLAT

			53

Location Rig up

Drilling and Remarks:

First reported as
#1 Trexler Located
IN C E L W 2 NE
Change To The
Above

RECORD

Cased in., ft.Sand Gas Oil Total Depth

PRODUCTION

1st 24 hrs. Nat. 1st 24 hrs. after shot Gas Cu. Ft.Dry Hole Abandoned

Date

MAR 2 - 1938

19

N. D. Hatfield

Scout

Graham KANSAS

Map No. 65 Sec. 15 Twp. 9 R. 21WWell No. 1 MorelContinental & Cities Service Company

Contractor

COMPLETED**SECTION PLAT**1320 C W L E $\frac{1}{2}$ NE
Ft. from N. Line

Ft. from S. Line

990 Ft. from E. Line

Ft. from W. Line

			0

Location _____

Rig up _____

Drilling and Remarks:

RECORDCased 7 in., 3712 ft.Sand Arb 3712

Gas _____

Oil _____

Total Depth 3721**PRODUCTION**

1st 24 hrs. Nat. _____

1st 24 hrs. after shot _____

Gas _____ Cu. Ft.

Dry Hole _____

Abandoned _____

Date

APR 20 1938H. D. Hatfield19Scout

Pot 2105

NOT