

# KANSAS


FORM 51 5M 1-42 PETROL

Graham

Section 15 Township 9 Range ~~12-W~~ <sup>21-W</sup>

Well No. #4 Morel

Company Continental & Cities

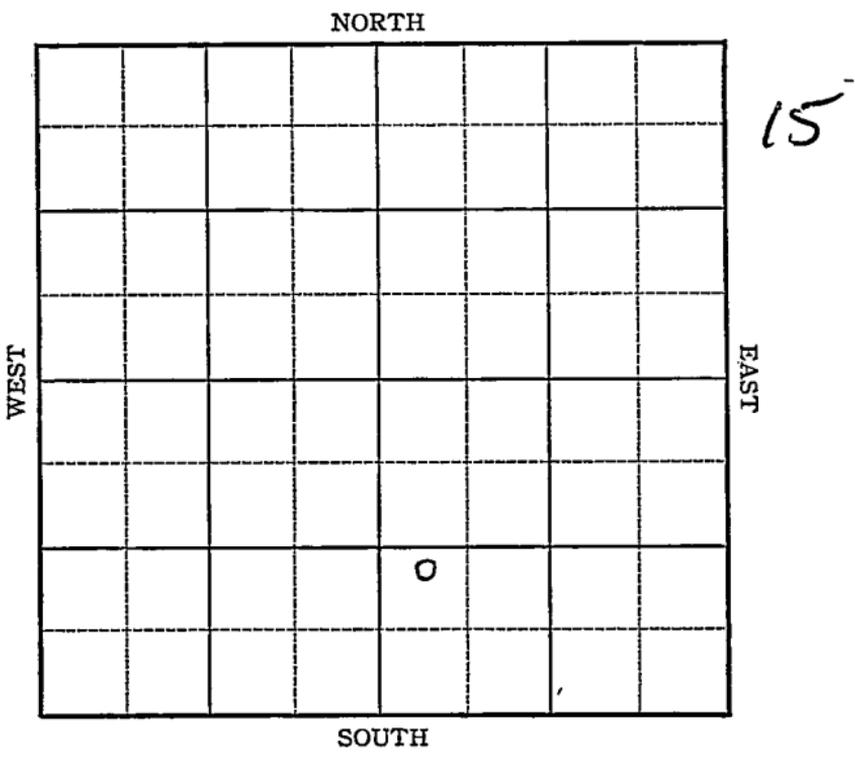

Sec. 15 Twp. 9 R. 21-W

Well No. #4 Morel Farm

Continental & Cities Service Oil Company


\_\_\_\_\_ Ft. from N. Line

1065 Ft. from S. Line

\_\_\_\_\_ Ft. from E. Line

330 Ft. from W. Line

*Elev. 2232*

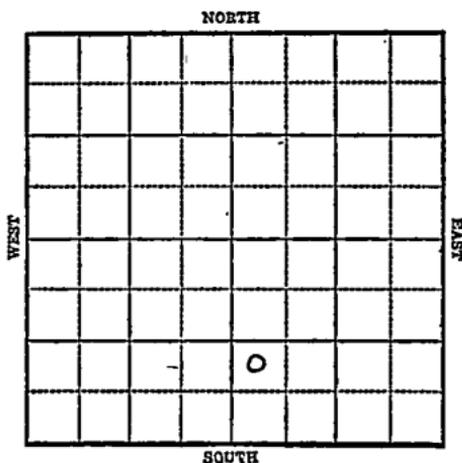

1943

R E P O R T

5/19 Derrick

5/26 10" @ 242' WOC.

6/2 Drlg. 3433

6/9 Topeka 3183  
Lans 3413  
Arb 3705

T.D. 3709 Sat.  
7" @ 3707 RUST

6/16 T.D. 3714  
Swab 1888 oil in 4 hrs.

6/23 Arb. 3705  
7" @ 3707'  
T.D. 3714'  
Echo Pot 28366  
Max. 3000  
Gravity 29.3

**COMPLETED**

Graham

**KANSAS**  
 Map No. 65 Sec. 15 Twp. 9 R. 21W

Well No. 4 Morel

Continental & Cities Company

FIRST REPORT Service Oil Contractor

NW SW SE

SECTION PLAT

\_\_\_\_\_ Ft. from N. Line

1065 Ft. from S. Line

\_\_\_\_\_ Ft. from E. Line

330 Ft. from W. Line

		o	

MOREL POOL

Location \_\_\_\_\_

Rig up \_\_\_\_\_

Drilling and Remarks:

Derrick

RECORD

Cased \_\_\_\_\_ in., \_\_\_\_\_ ft.

Sand \_\_\_\_\_

Gas \_\_\_\_\_

Oil \_\_\_\_\_

Total Depth \_\_\_\_\_

PRODUCTION

1st 24 hrs. Nat. \_\_\_\_\_

1st 24 hrs. after shot \_\_\_\_\_

Gas \_\_\_\_\_ Cu. Ft.

Dry Hole \_\_\_\_\_

Abandoned \_\_\_\_\_

Date

MAY 1 9 1943 19

S. J. LEWIS Scout

Graham

KANSAS  
Map No. 65 Sec. 15 Twp. 9 R. 21WWell No. 4 MorelContinental & Cities Service  
Company

COMPLETED

Contractor

NW SW SE

SECTION PLAT

		o	

\_\_\_\_\_ Ft. from N. Line

1065 Ft. from S. Line

\_\_\_\_\_ Ft. from E. Line

330 Ft. from W. Line

MOREL POOL

Location \_\_\_\_\_

Rig up \_\_\_\_\_

Drilling and Remarks:

*Cor X 3705**7" C 3707**Ech Rd X 28366**Wax 3000**29<sup>th</sup> 44*

Date

JUN 23 1943 19

RECORD

Cased \_\_\_\_\_ in., \_\_\_\_\_ ft.

Sand ~~\_\_\_\_\_~~

Gas \_\_\_\_\_

Oil \_\_\_\_\_

Total Depth 8714

PRODUCTION

1st 24 hrs. Nat. \_\_\_\_\_

1st 24 hrs. after shot \_\_\_\_\_

Gas \_\_\_\_\_ Cu. Ft.

Dry Hole \_\_\_\_\_

Abandoned \_\_\_\_\_

S. J. LEWIS Scout