

# KANSAS


FORM 51. 5M 6-46 PETROL

Graham County

Section 15 Township 9 Range 21W

Well No. 7 Trexler

Company Continental

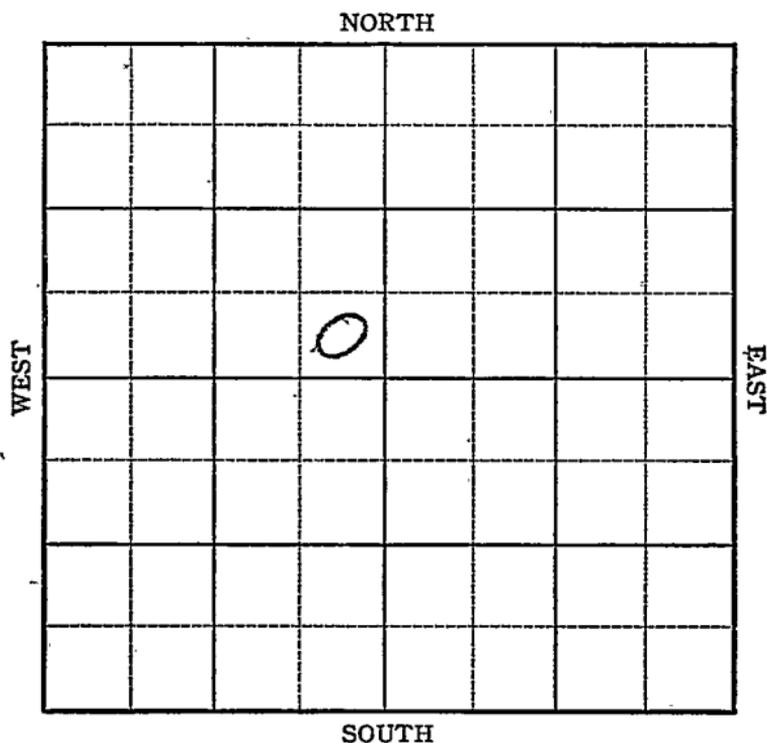

Sec. 15 Twp. 9 R. 21W

Well No. #7 Tréxler Farm

Continental Company

Morel


\_\_\_\_\_ Ft. from N. Line

330 \_\_\_\_\_ Ft. from S. Line

330 \_\_\_\_\_ Ft. from E. Line

\_\_\_\_\_ Ft. from W. Line

SE NW

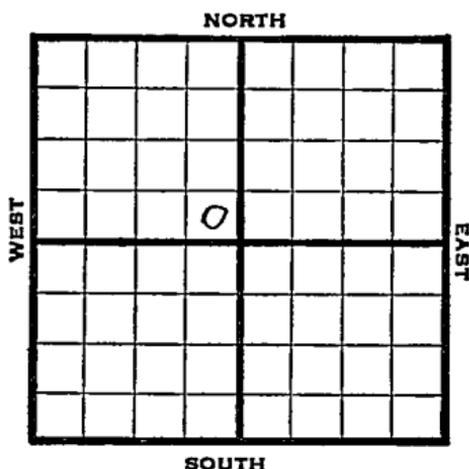

1946 Elev. 2223' REPORT

8/7 Location  
 8/13 13" @ 247  
 Drlg 461'  
 8/20 Drlg 3300'  
 8/27 Arb 3682'  
 TD 5688'  
 5" @ 3684, RUST  
 9/5 TD 3703 swb 190' oil in 6 hrs  
 9/10 " " "  
 9/18 Arb 3682'  
 6" @ 3684'  
 Depth POT 3000  
 TD 3703'  
 Grav. 27

COMPLETED

KANSAS

Kansas

Pool Name MorelMap No. 65 Sec. 15 Twp. 9 R. 21WWell No. 7 TrexlerContinental Company

FIRST REPORT Contractor

SE NW

## SECTION PLAT


         Ft. from N. Line330 Ft. from S. Line330 Ft. from E. Line         Ft. from W. LineGraham CountyLocation XRig up         

Drilling and Remarks:

## RECORD

Cased          in.,          ft.Sand         Gas         Oil         Total Depth         

## PRODUCTION

1st 24 hrs. Nat.         1st 24 hrs. after shot         Gas          Cu. Ft.Dry Hole         Abandoned         

Date

AUG 7 1946 19S. J. LEWIS Scout

**KANSAS** Pool Name Morel Pool  
 Map No. 62 Sec. 15 Twp. 9 R. 21W  
 Well No. 7 Trexler

Continental Company  
**COMPLETED**

Contractor

SE NW

*E/2223*

SECTION PLAT

\_\_\_\_\_ Ft. from N. Line  
330 Ft. from S. Line  
330 Ft. from E. Line  
 \_\_\_\_\_ Ft. from W. Line


Graham County

Location \_\_\_\_\_

Rig up \_\_\_\_\_

Drilling and Remarks:

*Per #3682*  
*6" @ 3684*  
*Depth 3000*

*27° SW*

**RECORD**

Cased \_\_\_\_\_ in., \_\_\_\_\_ ft.  
 Sand \_\_\_\_\_  
 Gas \_\_\_\_\_  
 Oil \_\_\_\_\_  
 Total Depth 3718

**PRODUCTION**

1st 24 hrs. Nat. \_\_\_\_\_  
 1st 24 hrs. after shot \_\_\_\_\_  
 Gas \_\_\_\_\_ Cu. Ft.  
 Dry Hole \_\_\_\_\_  
 Abandoned \_\_\_\_\_

Date

SEP 18 1946 19

S. J. LEWIS Scout