


Section 15 Township 9 Range 21-W

Well No. #9 Drexler


Company Continental  
Morel Pool

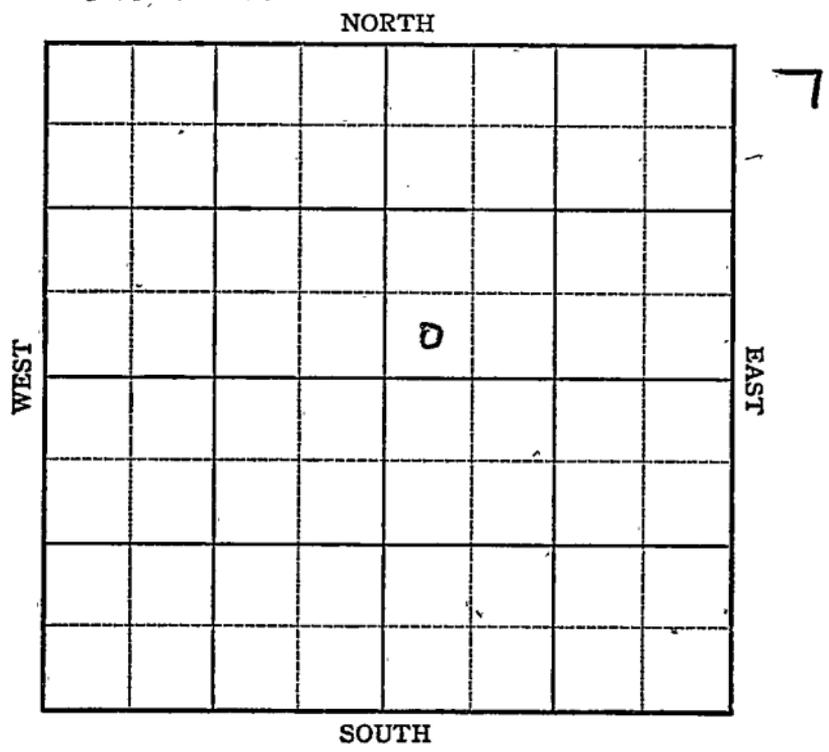

Sec. 15 Twp. 9 R. 21-W

Well No: # 9 Drexler Farm \_\_\_\_\_  
Continental Company

Morel /  
 \_\_\_\_\_ Ft. from N. Line  
330 Ft. from S. Line  
 \_\_\_\_\_ Ft. from E. Line  
330 Ft. from W. Line  
 SW NE

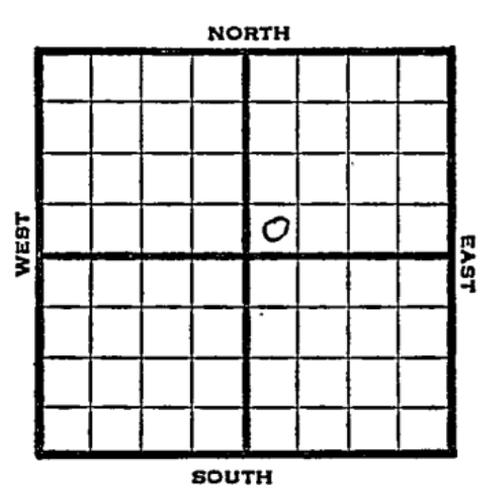

1947	Elev. 3209'	REPORT
6/18	Location	
6/24	Derrick	
7/1	"	
7/8	"	
7-16	"	
7/22	"	
7/29	"	
8/6	Drlg 2437'	
8/13	Arbuckle 3668 6" @ 3681 TD 3683 RUST	
8/20	Lansing 3371	
8/27	TD 3686' Swb 80 bbls oil PH, 2 hrs.	
9/3	Arb. 3668' 6" @ 3681' Depth Pot 3000' Gr. 27.0 TD 3686'	

COMPLETED

Map No. \_\_\_\_\_ Sec. 15 Twp. 9 R. 21W

Well No. 9 Drexler

Continental Company

**FIRST REPORT**

Contractor \_\_\_\_\_

SW NE

**SECTION PLAT**

\_\_\_\_\_ Ft. from N. Line

330 Ft. from S. Line

\_\_\_\_\_ Ft. from E. Line

330 Ft. from W. Line

		o	

Graham County

Location X

Rig up \_\_\_\_\_

Drilling and Remarks:

**RECORD**

Cased \_\_\_\_\_ in., \_\_\_\_\_ ft.

Sand \_\_\_\_\_

Gas \_\_\_\_\_

Oil \_\_\_\_\_

Total Depth \_\_\_\_\_

**PRODUCTION**

1st 24 hrs. Nat. \_\_\_\_\_

1st 24 hrs. after shot \_\_\_\_\_

Gas \_\_\_\_\_ Cu. Ft.

Dry Hole \_\_\_\_\_

Abandoned \_\_\_\_\_

Date

JUN 18 1947 19

S. J. LEWIS Scout

