

KANSAS


FORM 51 5M 1-42 PETROL

Graham

Section 15 Township 9 Range 23 W

Well No. #1 Sharp

Company W. S. Brodrick

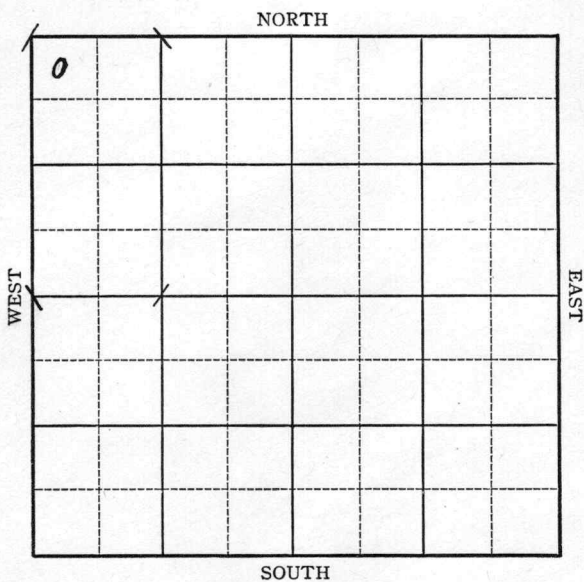

KANSAS

Graham

Sec. 15 Twp. 9 R. 23-W

Well No. #1 Sharp Farm

W. S. Broderrich Company

Wildcat


330 Ft. from N. Line

 Ft. from S. Line

 Ft. from E. Line

330 Ft. from W. Line

Elev. 2324

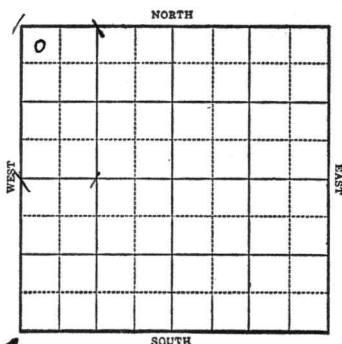

1943

R E P O R T

6/16 Rotary

6/23 8" @ 156
Drlg. 1500'

6/30 Anhy 1959
Topeka 3440
Lans 3650
Drlg. 3700'

7/7 BKC 3802
Congl 4104
Arb 4170 ?
T. D. 4183
No shows SD

7/14 Arb. 4170
T.D. 4188'
No shows.

ABANDONED


KANSAS
Map No. 60 Sec. 15 Twp. 9 R. 23W

Well No. 1 SharpW. S. Broderich CompanyFIRST REPORT Contractor

NW/C

330 Ft. from N. Line Ft. from S. Line Ft. from E. Line330 Ft. from W. Line

SECTION PLAT

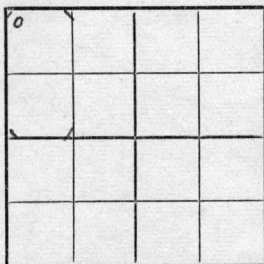

WILDCAT

Location Rig up

Drilling and Remarks:

Rotary

RECORD

Cased in., ft.Sand Gas Oil Total Depth

PRODUCTION

1st 24 hrs. Nat. 1st 24 hrs. after shot Gas Cu. Ft.Dry Hole Abandoned

Date

JUN 16 1943 19 S. J. LEWIS Scout

KANSAS

Graham

Map No. 66 Sec. 15 Twp. 9 R. 23WWell No. 1 SharpW. S. Broderick Company

Contractor

ABANDONED

NW/ C

SECTION PLAT

6			

330 Ft. from N. Line Ft. from S. Line Ft. from E. Line330 Ft. from W. Line

WILDCA T

Location Rig up

Drilling and Remarks:

*Per 84170**No shows*

RECORD

Cased in., ft.Sand Gas Oil Total Depth 4188

PRODUCTION

1st 24 hrs. Nat. 1st 24 hrs. after shot Gas Cu. Ft.Dry Hole Abandoned

Date

JUL 14 194319S. J. LEWIS

Scout