

Graham

KANSAS

SECTION 15 TOWNSHIP 9 RANGE 24W

WELL NO. #1 Nickelsen


COMPANY Imperial Drlg.

NORTH

~~X~~ NE NE NE

WEST

EAST

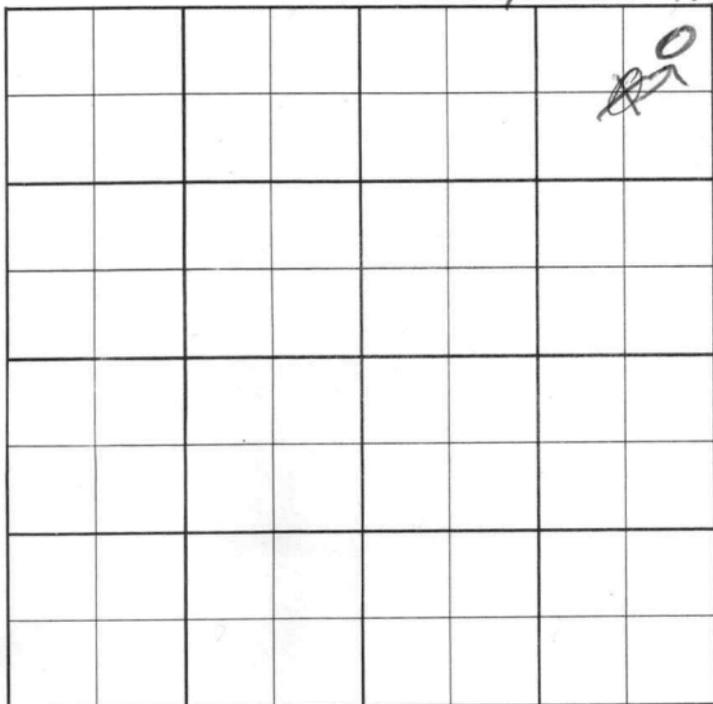

SOUTH

WILDCAT

FORM 513 SUNRAY

County Graham Elev. _____
Sec. 15 Twp. 9 Rgs. 24W
Company Imperial Drlg.
Farm Name Nickelsen No. 1

TOPS	DEPTH	LOG	DATUM	Loc. in Sec.
Anh.				C NE NE
Tp.				
H.				
Tr.				
Dg.				
Bl.				
L.				Geol. _____
K.C.				Contr. _____
B.K.C.				Harris-Burt T
Ce.				Pool <u>WOLLY</u>
C.				<u>Wildcat</u>
M.				
M.				
K.				
Mz.				
Me.				
V.				
S.				
S.				
A.				
R.				
Pe.				FIRST REPORT
G.				APR 3 '57
T.D.				

Date Comm. _____

Location _____

5

Co.

R.

CORRECTION

FORM 513 SUNRAY

2494

County Graham Elev. 2488
 Sec. 15 Twp. 9 Rge. 24W
 Company Imperial Drlg.
 Farm Name Nickelsen No. 1

TOPS	DEPTH	LOG	DATUM	Loc. in Sec.
Anh.	2149			NE NE NE
Tr.	3796			
H.	3821			
Dg.				
Bl.				
L.	3836			
K.C.				Geol.
B.K.C.				Contr.
Ce.				Harms-Burt Tl
C.				Pool
M.				Wildcat
M.				
K.				
Mz.				
Mq.				
V.				
S.				
S.				
A.				
R.				
Pe.				
G.				
T.D.	4058			JUN 26 1957 COMPLETE

Date Comm. _____

Location. APR 10 '57 ✓ APR 17 '57 APR 24 '57

MAY 1 '57 ✓ MAY 8 '57 5-1-57 858

193/150 3487 MAY 15 '57 DST

3858-68 lbs rec 135' oil +

65' HOCM BHT 1360/20 DST

3895-3908 lbs 2 wcl 1200'

Oil rec 120' oil + 120' Mdy

oil + 60' OCM BHT 1260/20

DST 3908-13 lbs 1440' SW

Co. No. Sec. T. R.

BHP 1200/20" DST 3980-4000
 30" 1600' GIP rec 120' HOCM
 BHP 1000/20" DST 4006-24
 of 40" G/40" rec 1200' oil
 BHP 1190/20" DST 4023-58
 of 30" rec 12' md BHP 0
 5 1/2 @ 4058 / MAY 22 57 WOC JUN 29 57
 CO PF 3990-93 \$ 2 1/4
 Boph nolw 2 hrs PF 26/
 4010-14 \$ 12 Boph nolw
 Both 2ms 18 \$ 50 Boph
 nolw 3 hrs \$ 12 Boph
 nolw 3 hrs 1500' S.B. JUN 5 '57
 POP. JUN 2 '57 JUN 16 '57 SINCE '57 BH Bomb
 Pot 785 Bopd nolw
 gas 41.2%