


Graham

KANSAS
24W

SECTION 15 TOWNSHIP 9S RANGE 24W

WELL NO. #4 Nickelson

COMPANY Imperial Drlg.

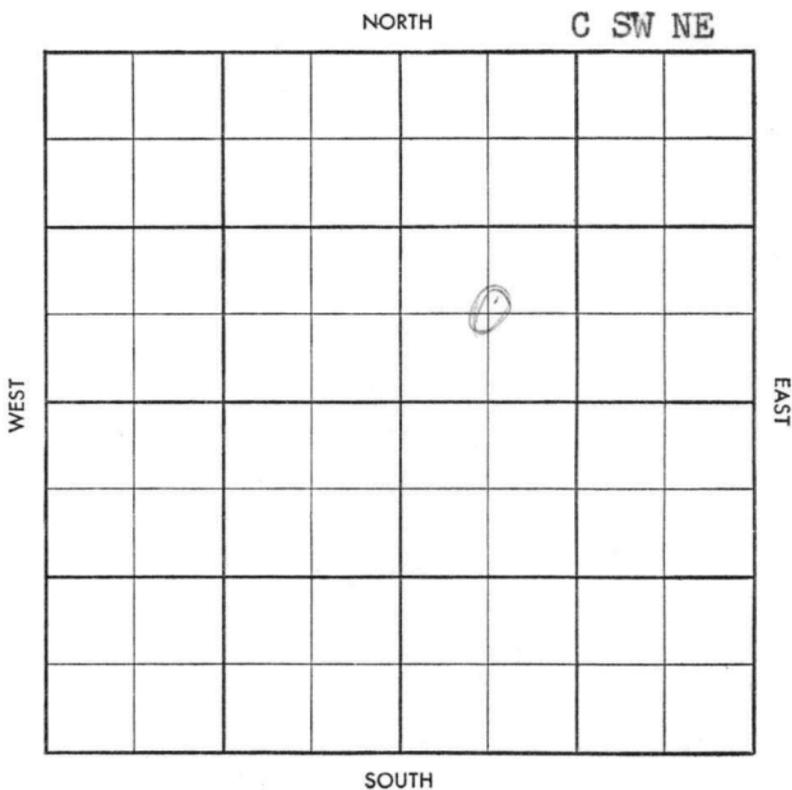

Twp. ~~_____~~ Pool ~~_____~~
 Co. ~~_____~~ Facet ~~_____~~

S-513-B

County Graham Elev. _____
 Sec. 15 Twp. 9 Rge. 24W
 Company Imperial Drlg.
 Farm Name Nickelson No. 4

TOPS	DEPTH	LOG	DATUM
Anh.			
Tp.			
H.			
Tr.			
Dg.			
B.L.			
L.			
K.C.			
B.K.C.			
Ce.			
C.			
M.			
M.			
K.			
Mz.			
Mq.			
V.			
S.			
S.			
A.			
R.			
Pf.			
G.			
T.D.			

Loc. in Sec. C SW NE
 Geol. _____
 Contr. _____
Co. Tools #2
 Pool Holly



Date Comm. _____
Location

Co.
 Sec.
 No.
 Sec.
 T.
 R.

Twp. X Pool Holly
 Co. X Facet X

5-513-B

County Graham Elev. 249988 249601
 Sec. 15 Twp. 9 Rge. 2NW
 Company Imperial Drlg.
 Farm Name Nickelson No. 4

TOPS	DEPTH	LOG	DATUM
Anh.	<u>2148</u>		
Tp.			
H.	<u>3797</u>		
Tr.	<u>3822</u>		
Dg.			
B.L.			
L.	<u>3838</u>		
K.C.			
B.K.C.			
Ce.			
C.			
M.			
M.			
K.			
Mz.			
Mq.			
V.			
S.			
S.			
A.			
R.			
Pf.			
G.			
T.D.	<u>4048</u>		

Loc. in Sec. C SW NE

Geol. _____
 Contr. _____
 Co. Tools #2

Pool Holly SE

COMPLETE	
0	
JUL 30 '58	

Date Comm. 5-29-58

Location QUN 3 '58 03270 JUN 11 '58

DST 3855-75 2hrs 195' HOcm BHP
950 DST 3894-3908 1hr 480' gip
120' HOcm 120' oil BHP 1130 DST
3907-20 1hr 690' W BHP 1260' DST
3957-80 2hr. 1245' gip 200' Ocm
120' W BHP failed DST 3980-96 1hr
60' HOcm 90' oil BHP 470 DST 4000
-15' 60" 960' gip 60' V HOcm 180'
oil BHP 770

PSY 4013-48 1 hr 12' M BHP 65-

52 4048/100 JUN 18 '58 JUN 25 '58 16/4003-07

16/3986-90 ~~16~~ Δ communicated

JUL - '58 Δ 51030 ph + trw 8 hrs

600' 0 B pop JUL 9 '58 JUL 16 '58

JUL 23 '58 JUL 30 '58 Phyp 183 Bopd NW

38° qv Log 3986-4007

15-9-24W

CSWNE