
FORM 51 25M 3-49 PETROL Graham KANSAS

Section 15 Township 9 Range 25W

Well No. #1 Minium

Company Keating Drlg.

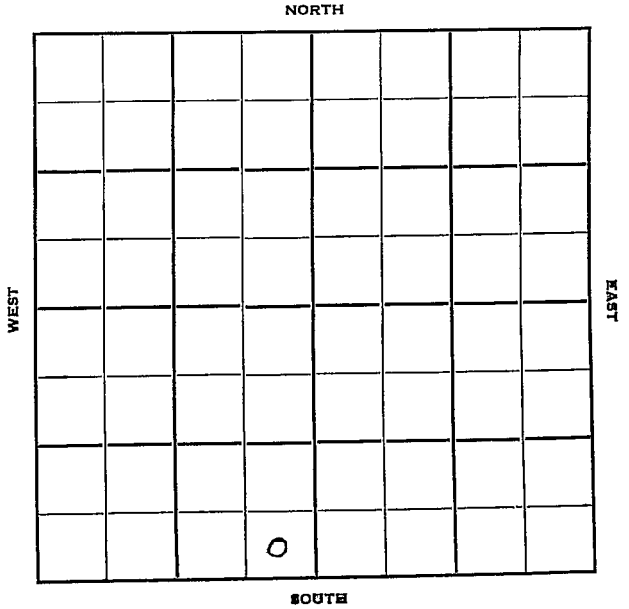

FORM 252-B
COM 8-51 TPCO.

HOT FILE


Sec. 15 Twp. Graham 9 R. KANSAS 25 W

Well No. # 1 Minium Farm

Keating Drlg. Company

Keating Contractor

Wildcat

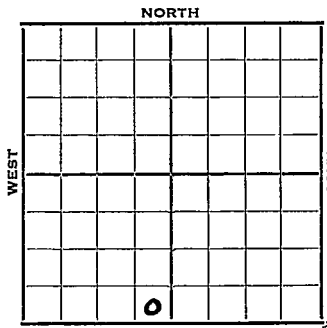

Ft. from N. Line

330 Ft. from S. Line

330 Ft. from E. Line

Ft. from W. Line

SE SE SW

Lion - Dry Hole Money

MCPC has NW of 23

1952	Elev. 2591' REPORT
9/24	MIR
10/1	8" @ 196 Drlg. 3065
10/8	Anhy 2267', Topeka 3658, Heeb 3861', Toronto 3884, Lansing 3901, BKC 4142 Pipe Stuck @ 4284'
10/15	Cong 4417, Miss 4449, Miss Lm 4496 Drlg. 4525'
10/22	Spud 9-24-52 D&A TD 4655' 8" @ 196' Anhy 2267', Top. 3658', Heeb 3861', Tor. 3884', Lans 3901', B KC 4142', Cong. 4417', Miss. 4449', Miss lm 4496', Viola 4572', Simp 4580', Arb. 4624' TD 4655' D&A

ABANDONED

FORM 275 FOR SALE BY KANSAS BLUE PRINT CO.


County Graham State Kansas

Sec. 15 (Blk. Twp.) 9 (Sur. Rge.) 25W Map No.

Operator Keating Drlg.

Well No. 1 Farm Minium

Elev. Location SE SE SW

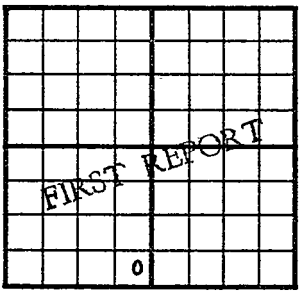

330 Ft. From S Line SW

330 Ft. From E Line Quarter

1st. Report SEP 24 1952

Completion

Remarks Lion - DHM

Keating - Contr.

Spudding Date

Drlg. Data MCPC has NW of 23 Wildcat

M I R

J. G. McGEHEE

FORM 275 FOR SALE BY KANSAS BLUE PRINT CO.


County Graham State Kansas

Sec. 15 (Blk. Twp.) 9 (Sur. Rge.) 25W Map No.

Operator Keating Drlg.

Well No. 1 Farm Minium

Elev. 2591 Location SE SE SW

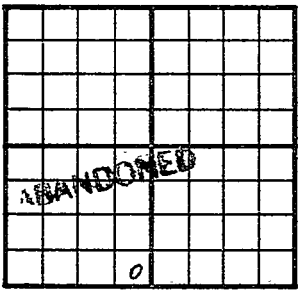

330 Ft. From S Line SW

330 Ft. From E Line Quarter

1st. Report

Completion OCT 22 1952

Remarks Wildcat

Keating - Contr.

Spudding Date 9-24-52

Drlg. Data D & A TD 4655

8" @ 196 Anhy 2267 Top. 3658

Heeb. 3861 Tor. 3884 Lans. 3901

B KC 4142 Cong. 4417 Miss. 4449

Miss.lime 4496 Viola 4572 Simp. 4580

Arb. 4624 TD 4655

D & A

J. G. McGEHEE