


**WELL LOG BUREAU--KANSAS GEOLOGICAL SOCIETY**  
**508 East Murdock, Wichita, Kansas**

Company- TRANSIT CORP. ET AL  
 Farm- Becker "B" No. 1

SEC. 34 T. 9 R. 16W  
 SW SE SW

Total Depth. 3538  
 Comm. 9-11-53 Comp. 9-23-53  
 Shot or Treated.  
 Contractor.  
 Issued. 11-7-53

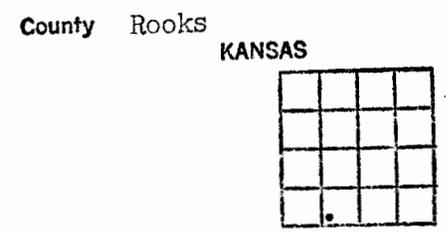

Elevation. 2037 DF

Production. Pmp. 70 BO & NW

Figures indicate Bottom of Formations.

shale & lime	205
shale	300
shale & sand	805
sand & shale	1050
shale & red bed	1200
anhydrite	1230
anhydrite	1240
shale & lime	1525
shale & shells	1843
shale & lime	2190
shale & shells	2320
shale & lime	2585
shale & shells	2740
lime, shale	2830
shale	2919
shale & lime	3161
lime	3210
lime, shale	3218
lime	3225
lime & shale	3268
lime	3277
lime & shale	3353
lime	3506
lime	3538
Total Depth	

Tops: Sample

Anhydrite	1200
Base-Anhydrite	1240
Topoka	2888
Heebner	3127
Toronto	3145
Lansing-Kansas City	3393
Conglomerate	3470
Simpson Shale	3486
Simpson Dolomite	3496
Simpson Sand	3518
Arbuckle	3526