


Section 16 Township 9 Range 15W

Well No. #1 Tatkenherst

Company Beach & Talbott

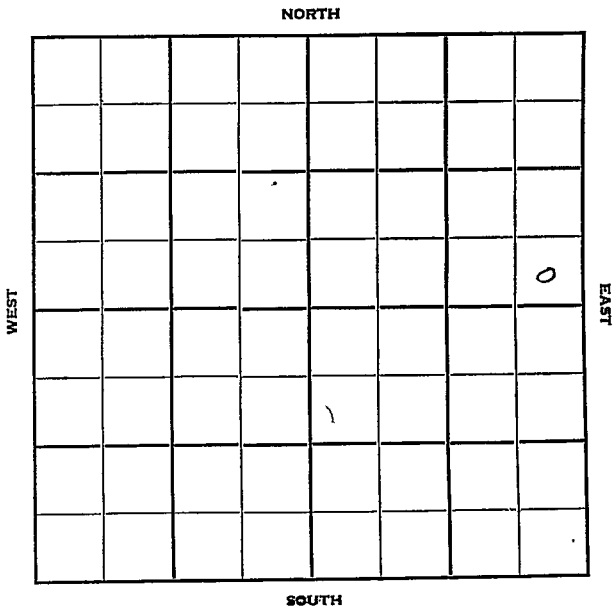

Sec. 16 Twp. 9 R. 15W

Well No. #1 Tatkenhorst Farm

Beach & Talbott Company

Deek Drlg. Contractor

Wildcat


Ft. from N. Line

330 Ft. from S. Line

330 Ft. from E. Line

Ft. from W. Line

SE SE NE

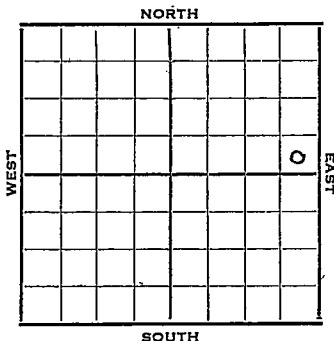

1952 Elev. 2068' REPORT

8/20 Spud 8-10-52  
8" @ 193'  
Anhy 1310'  
Drlg. 3239'

8/27 Heeb. 3243 Tor. 3265 KC 3293  
DST 3358-73 1 hr. 8' SOCM  
DST 3472-97 1 hr. 10' M  
DST 3510-30 1 hr. 15' SOCM  
430# Cong. 3692 Simp 3906  
Arb. 3957 circu @ 3962

9/4 Spud 8-10-52  
D&A TD 3964' 8" @ 193'  
Anhy 1310 Heeb. 3243  
Tor. 3265 KC 3293  
DST 3358-73 open 1 hr. rec.  
8' SOCM 0#  
DST 3472-97 open 1 hr. rec. 10' mud  
DST 3510-30 open 1 hr. rec. 15'  
SOCM 430#  
Cong. 3692 Simp. 3906  
Arb. 3957 TD 3964' D&A

**ABANDONED**

County Osborne State Kansas

Sec. 16 (Blk. 9) (Sur. 15W) Map No.

Operator Beach & Talbott

Well No. 1 Farm Tatkenhorst

Elev. Location SE SE NE


330 Ft. From S Line NE

330 Ft. From E Line Quarter

1st. Report AUG 20 1952

Completion

Remarks

Desk Drlg. - Contr.

Spudding Date 8-10-52

Drlg. Data Wildcat

8" @ 193 Anhy 1310 Drlg. 3239

J. G. MCGHEE

