


Section 16 Township 9 Range 17W

Well No. 1 Carmichael

Company Atlantic

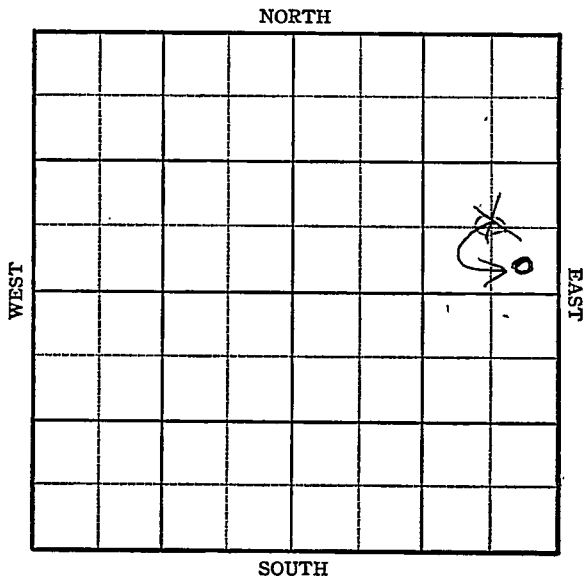



Sec. 16 Twp. 9 R. 17-W

Well No. #1 Carmichael Farm


Atlantic Company

330 Ft. from N. Line

~~660~~ Ft. from S. Line

380 Ft. from E. Line

~~660~~ Ft. from W. Line

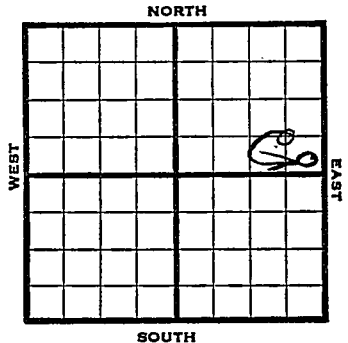

SE NE

Year	REPORT
1945	Elev. 2076' 7"
11/21	RUR
11/28	10" @ 620 WOC
12/5	Drlg. 2370'
12/12	Topeka 2966 Lans 3206 TD 3250 7" @ 3250 RUST
12/20	" " "
12/29	" " "
1946	
1/10	Drlg. 3373' 1700' water.
1/17	T.D. 3437' 187' of 5" liner 3424' WOC.
1/24	Cong 3507' Drlg. 3527'
1/31	Arb. 3539-47' T.D. P.B. to 3475' Run liner.
2/7	" "
2/14	5" liner at 3445' 35 shots 3429-35' 2000 acid. Swab 2 1/2 oil & 2 water per hour.
2/21	" " "
2/28	P.B. 3445' 12 shots 3428-33 2000 acid. 12 shots 3277-83 4000 acid. Swab 3 oil & 20 water per hour. Squeezed.
3/4	2000 acid. Pump 10l oil 48 hours.
3/14	" " "
3/21	" " "
3/28	" " "

OVER

1946

4/3 Lans 3206
Arb. 3539
7" @ 3250
5" liner @ 3445
Perf. Lens. 6000 acid.
TD 3547'
Pump 35 oil plus 25% wtr. Pot.
Grav. 24.0

COMPLETED

KANSAS Pool Name Wildcat
 Map No. 64 Sec. 16 Twp. 9 R. 17W
 Well No. 1 Carmichael

Atlantic


Company

~~FIRST REPORT~~

Contractor

C SE NE

SECTION PLAT

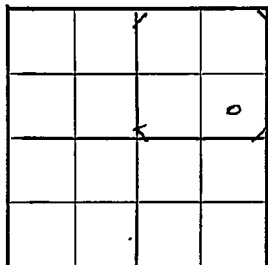

Ft. from N. Line

660 Ft. from S. Line660 Ft. from E. Line

Ft. from W. Line

Rooks County

Location _____

Rig up _____

Drilling and Remarks:

RUR

RECORD

Cased _____ in., _____ ft.

Sand _____

Gas _____

Oil _____

Total Depth _____

PRODUCTION

1st 24 hrs. Nat. _____

1st 24 hrs. after shot _____

Gas _____ Cu. Ft.

Dry Hole _____

Abandoned _____

Date

NOV 21 1945 19S. J. LEWIS Scout

KANSAS

Kansas

Pool Name Wildcat

Map No. 64

Sec. 16

Twp. 9

R. 17W

Well No. 1 Carmichael

Atlantic

Company

COBRECTON

Contractor

SE NE

SECTION PLAT

_____ Ft. from N. Line

330 Ft. from S. Line

380 Ft. from E. Line

_____ Ft. from W. Line

			↙

Rocks County

Location _____

Rig up _____

Drilling and Remarks:

reported C SE NE

RECORD

Cased _____ in., _____ ft.

Sand _____

Gas _____

Oil _____

Total Depth _____

PRODUCTION

1st 24 hrs. Nat. _____

1st 24 hrs. after shot _____

Gas _____ Cu. Ft.

Dry Hole _____

Abandoned _____

Date

NOV 28 1945

19

S. J. LEWIS

Scout

